

STATE OF KANSAS  
STATE CORPORATION COMMISSION


15-101-20422-0000

WELL PLUGGING RECORD

Give All Information Completely  
Make Required Affidavit  
Mail or Deliver Report to  
Conservation Division  
State Corporation Comm.  
245 North Water  
Wichita, KS 67202

Lane \_\_\_\_\_ County, Sec. 35 Twp. 19 Rge. 29 E/W  
Location as "NE/CNW $\frac{1}{4}$ SW $\frac{1}{4}$ " or footage from lines \_\_\_\_\_  
SW NW NW

Lease Owner Kansas Oil Corporation  
Lease Name DAVIS "A" Well No. 1  
Office Address 555 No. Woodlawn, Suite 2, Wichita, Ks  
Character of Well (Completed as Oil, Gas or Dry Hole) \_\_\_\_\_  
Dry Hole

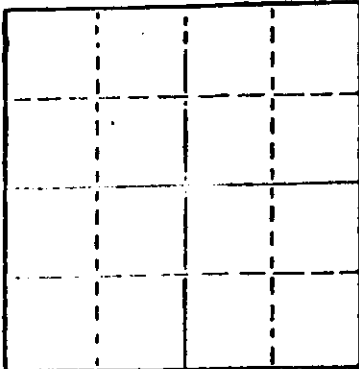

Locate well correctly on above  
Section Plot

Date Well completed Jan. 3 1980  
Application for plugging filed (verbally) Jan. 3 1980  
Application for plugging approved (verbally) Jan. 3 1980  
Plugging commenced Jan. 3 1980  
Plugging completed Jan. 3 1980  
Reason for abandonment of well or producing formation \_\_\_\_\_  
No commercial quantity of oil or gas encountered  
If a producing well is abandoned, date of last production \_\_\_\_\_  
19

Was permission obtained from the Conservation Division or  
its agents before plugging was commenced? Yes

Name of Conservation Agent who supervised plugging of this well Gilbert Balthazor  
Producing formation \_\_\_\_\_ Depth to top \_\_\_\_\_ Bottom \_\_\_\_\_ Total Depth of Well 4660'  
Show depth and thickness of all water, oil and gas formations.

OIL, GAS OR WATER RECORDS

CASING RECORD

FORMATION	CONTENT	FROM	TO	SIZE	PUT IN	PULLED OUT

Describe in detail the manner in which the well was plugged, indicating where the mud, fluid  
was placed and the method or methods used in introducing it into the hold. If cement or other  
plugs were used, state the character of same and depth placed, from \_\_\_\_\_ feet to  
\_\_\_\_\_ feet for each plug set.

T.D. 4660'

Set 1st plug at 800' with 70 sacks  
2nd plug at 300' with 20 sacks  
3rd plug at 40' solid bridge with 10 sacks  
rathole with 5 sacks.

Cemented with 50/50 posmix, 6% gel.  
Plug was down at 9:00 a.m., 01-03-80.

RECEIVED  
STATE CORPORATION COMMISSION  
1-9-80  
JAN - 9 1980

(If additional description is necessary, use BACK of this sheet)

Name of Plugging Contractor Abercrombie Drilling, Inc. CONSERVATION DIVISION  
Wichita, Kansas

STATE OF Kansas COUNTY OF Sedgwick, ss.  
Jack L. Partridge, Asst. Sec.-Treas. (employee of owner) or (owner or operator)  
of the above-described well, being first duly sworn on oath, says: That I have knowledge of  
the facts, statements, and matters herein contained and the log of the above-described well  
as filed and that the same are true and correct. So help me God.

(Signature) Jack L. Partridge  
801 Union Center, Wichita, Kansas 67202  
(Address)

SUBSCRIBED AND SWORN TO before me this 7th day of January, 1980



Sherrie L. Brooks  
Sherrie L. Brooks Notary Public.

My commission expires 08-21-82

CONTRACTOR'S WELL LOG

15-101-20422-0000

OPERATOR:  
 CONTRACTOR:  
 WELL NAME:  
 LOCATION:  
 SPUD DATE:  
 COMPLETION DATE:

Kansas Oil Corporation  
 Abercrombie Drilling, Inc.  
 Davis "A" #1  
 SW NW NW, Section 35-19-29  
 Lane County, Kansas  
 December 21, 1979  
 January 03, 1980

0	725	Sand and shale
725	1782	Shale and sand
1782	2159	Shale and lime
2159	2185	Anhydrite
2185	3185	Shale and lime
3185	3549	Lime and shale
3549	3664	Shale and lime
3664	4317	Lime and shale
4317	4328	Shale and lime
4328	4381	Lime
4381	4404	Lime and shale
4404	4653	Shale and lime
4653	4660	Lime
	4660	Rotary Total Depth

Spud hole at 6:15 p.m., December 21, 1979. Drilled 325' of 12 1/4" hole. Ran 8 joints of 8-5/8" new 20# casing. Set at 320.96' with 225 sacks of common cement, 3% Ca.Cl., 2% gel. Cement did circulate. Plug was down at 12:00 midnight, December 21, 1979.

T.D. 4660'. Set 1st plug at 800' with 70 sacks, 2nd plug at 300' with 20 sacks, 3rd plug at 40' solid bridge with 10 sacks, rathole with 5 sacks. Cemented with 50/50 posmix, 6% gel. Plug was down at 9:00 a.m., January 03, 1980.

SAMPLE TOPS:

Anhydrite 1859'  
 B/Anhydrite 2185'

RECEIVED  
 STATE COMMISSION  
 JAN 7 1980  
 DIVISION  
 Kansas

STATE OF KANSAS )  
 ) ss  
 COUNTY OF SEDGWICK )

Jack L. Partridge, Assistant Secretary-Treasurer of Abercrombie Drilling, Inc., does hereby state that the above and foregoing is a true and correct copy of the log of the Davis "A" #1, SW NW NW, Section 35-19-29, Lane County Kansas.

ABERCROMBIE DRILLING, INC.

BY Jack L. Partridge  
 Jack L. Partridge  
 Assistant Secretary-Treasurer

Subscribed and sworn to before me, a Notary Public, in and for the county and state aforesaid, as of this 7th day of January, 1980.



Sherrie L. Brooks  
 Sherrie Brooks, Notary Public

My commission expires 08-21-82.