


15-101 204010000

STATE OF KANSAS
STATE CORPORATION COMMISSION

Form CP-4

Give All Information Completely
Make Required Affidavit
Mail or Deliver Report to:
Conservation Division
State Corporation Commission
P. O. Box 17027
Wichita, Kansas 67217
NORTH

WELL PLUGGING RECORD

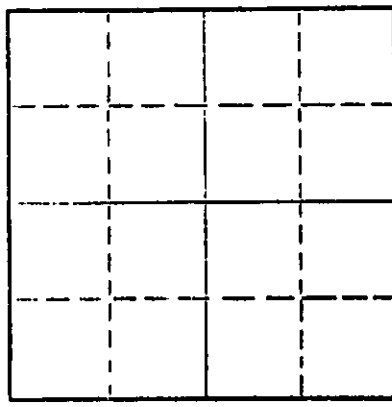

Locate well correctly on above
Section Plat

Lane _____ County. Sec. 35 Twp. 19 Rge. 29W (E) _____ (W) _____
Location as "NE/CNW/SE/SW" or footage from lines. W/2 W/2 SW
Lease Owner DONALD C. SLAWSON
Lease Name Davis 'O' Well No. 2
Office Address 200 Douglas Bldg. Wichita, KS 67202
Character of Well (completed as Oil, Gas or Dry Hole) Dry Hole
Date well completed September 2, 1979
Application for plugging filed September 2, 1979
Application for plugging approved September 2, 1979
Plugging commenced September 2, 1979
Plugging completed September 2, 1979
Reason for abandonment of well or producing formation Dry Hole

If a producing well is abandoned, date of last production _____ 19____
Was permission obtained from the Conservation Division or its agents before plugging was commenced? Yes

Name of Conservation Agent who supervised plugging of this well Gilbert Balthazor
Producing formation _____ Depth to top _____ Bottom _____ Total Depth of Well 4510 Feet
Show depth and thickness of all water, oil and gas formations.

OIL, GAS OR WATER RECORDS

CASING RECORD

FORMATION	CONTENT	FROM	TO	SIZE	PUT IN	PULLED OUT
	322.03'	surface	328'	8 5/8"		

Describe in detail the manner in which the well was plugged, indicating where the mud fluid was placed and the method or methods used in introducing it into the hole. If cement or other plugs were used, state the character of same and depth placed, from _____ feet to _____ feet for each plug set.

1st plug @ 850' w/70 sx
2nd plug @ 300' w/20 sx
Top plug @ 40' w/10 sx
5 sx in Rat Hole

RECEIVED
JAN - 2 1980
1-2-80
CONSERVATION DIVISION
WICHITA, KANSAS

(If additional description is necessary, use BACK of this sheet)
Name of Plugging Contractor Slawson Drilling Co., Inc.
Address 200 Douglas Building Wichita, KS 67202

STATE OF KANSAS, COUNTY OF SEDGWICK, ss.
James C. Remsberg (employee of owner) or (owner or operator) of the above-described well, being first duly sworn on oath, says: That I have knowledge of the facts, statements, and matters herein contained and the log of the above-described well as filed and that the same are true and correct. So help me God.

(Signature) James C. Remsberg
JAMES C. REMSBERG, Engineer
200 Douglas Building Wichita, KS 67202
(Address)

SUBSCRIBED AND SWORN TO before me this 7th day of December, 19 79

Sherry L. Kendall
Sherry L. Kendall, Notary Public.

My commission expires 6/12/79

SHERRY L. KENDALL
STATE NOTARY PUBLIC
Sedgwick County, Kansas
My Appt. Exp. 6/12/82

15-101-20401-0000

WELL LOG

OPERATOR: DONALD C. SLAWSON
 200 Douglas Building
 Wichita, Kansas 67202

LEASE: #2 Davis 'O'
 W/2 W/2 SW Sec. 35-19-29W
 Lane County, Kansas

CONTRACTOR: Slawson Drilling Co., Inc.
 200 Douglas Building
 Wichita, Kansas 67202

COMMENCED: August 25, 1979

COMPLETED: September 2, 1979

CASING: Surface - 8 5/8" @ 328' w/225 sx 60/40 poz

0 - 335 Surface
 335 - 2845 Shale
 2845 - 4370 Shale and Lime
 4370 - 4510 Lime
 4510 RTD

STATE OF KANSAS)
)
 COUNTY OF SEDGWICK)

SS.

RECEIVED
 STATE OF KANSAS COMMISSIONER

JAN - 2 1980

I, James C. Remsberg, of the Slawson Drilling Co., Inc. upon oath state that the above and foregoing is a true and correct copy of the log of the #2 Davis 'O' test.

James C. Remsberg
 JAMES C. REMSBERG

Subscribed and sworn to before me this 7th day of December, 1979.

Sherry L. Kendall
 SHERRY L. KENDALL, Notary Public

My Commission Expires: 6/12/82

