

15/01 20005 0001

STATE OF KANSAS
STATE CORPORATION COMMISSION

WELL PLUGGING RECORD

Give All Information Completely
Make Required Affidavit
Mail or Deliver Report to
Conservation Division
State Corporation Comm.
245 North Water
Wichita, KS 67202

Lane _____ County. Sec. 4 Twp. 19S Rge. 30 E/W
Location as "NE/CNW/SW" or footage from lines _____
C NE NE


Lease Owner Tom Younger
Lease Name Goering Well No. 1 (OWWO)
Office Address 710 Main Street, Victoria, Kansas 67671
Character of Well (Completed as Oil, Gas or Dry Hole) _____
Dry Hole

Date Well completed April 29, 1978
Application for plugging filed (verbally) April 29, 1978
Application for plugging approved (verbally) April 29, 1978
Plugging commenced April 29, 1978
Plugging completed April 29, 1978

Reason for abandonment of well or producing formation _____
No commercial quantity of oil or gas encountered
If a producing well is abandoned, date of last production _____
19 _____

Was permission obtained from the Conservation Division or
its agents before plugging was commenced? Yes

Name of Conservation Agent who supervised plugging of this well Leo Massey
Producing formation _____ Depth to top _____ Bottom _____ Total Depth of Well _____
Show depth and thickness of all water, oil and gas formations.

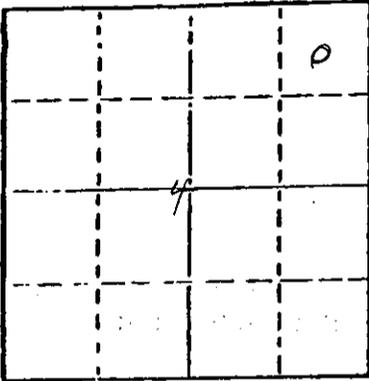

Locate well correctly on above
Section Plat

OIL, GAS OR WATER RECORDS

CASING RECORD

FORMATION	CONTENT	FROM	TO	SIZE	PUT IN	PULLED OUT

Describe in detail the manner in which the well was plugged, indicating where the mud fluid was placed and the method or methods used in introducing it into the hold. If cement or other plugs were used, state the character of same and depth placed, from _____ feet to _____ feet for each plug set.

Set 1st plug at 1025' with 70 sacks
2nd plug at 215' with 20 sacks
40' solid bridge with 10 sacks
Cemented with 50/50 posmix, 6% gel.

RECEIVED
STATE CORPORATION COMMISSION
MAY 12 1978
5-12-78
CONSERVATION DIVISION
Wichita, Kansas


(If additional description is necessary, use BACK of this sheet)

Name of Plugging Contractor Abercrombie Drilling, Inc.

STATE OF KANSAS COUNTY OF SEDGWICK ss.
Jack L. Partridge, Ass't. Sec.-Treas. (employee of owner) or (owner or operator) of the above-described well, being first duly sworn on oath, says: That I have knowledge of the facts, statements, and matters herein contained and the log of the above-described well as filed and that the same are true and correct. So help me God.

(Signature) Jack L. Partridge
801 Union Center, Wichita, Kansas 67202
(Address)

Subscribed and sworn to before me this 10th day of May, 1978

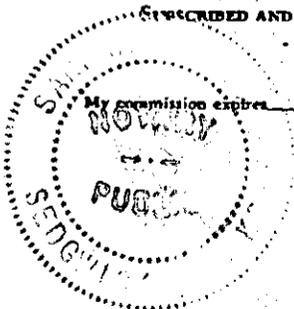

My commission expires July 21, 1979

Sandra Richman
Sandra Richman Notary Public

OPERATOR:
CONTRACTOR:
WELL NAME:
LOCATION:

SPUD DATE:
COMPLETION DATE:

Tom Younger
Abercrombie Drilling, Inc.
Goering #1 (OWWO)
C NE NE Section 4-19S-30W
Lane County, Kansas
April 28, 1978
April 29, 1978

Moved in and prepared to wash down on April 28, 1978.

T.D. 1379'. Washed down to 1379'. Set first plug at 1025' with 70 sacks, second plug at 215' with 20 sacks, third plug at 40' solid bridge with 10 sacks. Cemented with 50/50 posmix, 6% gel. Job complete at 12:30 a.m., April 29, 1978. State Plugger, Leo Massey.

STATE OF KANSAS)
) ss
COUNTY OF SEDGWICK)

Jack L. Partridge, Assistant Secretary-Treasurer of Abercrombie Drilling, Inc., does hereby state that the above and foregoing is a true and correct copy of the log of the Goering #1, C NE NE Section 4-19S-30W, Lane County, Kansas.

ABERCROMBIE DRILLING, INC.

By Jack L. Partridge
Jack L. Partridge,
Assistant Secretary-Treasurer

Subscribed and sworn to before me, a Notary Public, in and for the county and State aforesaid, as of this 10th day of May, 1978.



My commission expires July 21, 1979.

Sandra Richman
Sandra Richman, Notary Public

RECEIVED
STATE CORPORATION COMMISSION
MAY 12 1978