

CARD MUST BE TYPED

State of Kansas

CARD MUST BE SIGNED

NOTICE OF INTENTION TO DRILL

(see rules on reverse side)

Starting Date November 14, 1987.....
month day year

API Number 15- 101-21,440-0000

OPERATOR: License 06113 7245
Name Landmark Oil & Texas EL Dorado
Address 110 S. Main, Suite 510
City/State/Zip Wichita, KS 67202
Contact Person Jeff Wood
Phone 316/265-8181Nw.. SE .SE Sec23.... Twp.19... S, Rg.29..... X West
..... 990..... Ft. from South Line of Section
..... 990..... Ft. from East Line of Section

(Note: Locate well on Section Plat on reverse side)

CONTRACTOR: License # 5883
Name Warrior Drilling
City/State Wichita, KSNearest lease or unit boundary line ... 990..... feet
County.... Lane.....Lease Name.. Tennessee-Patter... Well #.. 1-23.....
Ground surface elevation unknown..... feet MSLWell Drilled For: Well Class: Type Equipment:
X Oil SWD Infield X Mud Rotary
Gas Inj Pool Ext Air Rotary
OWWO X Expl X Wildcat CableDomestic well within 330 feet: yes X no
Municipal well within one mile: yes X no
Depth to bottom of fresh water... 100.....
Depth to bottom of usable water .1300.....

If OWWO: old well info as follows:

Operator
Well Name
Comp Date Old Total Depth.....Surface pipe by Alternate: 1 2 X
Surface pipe planned to be set.. 250!.....
Conductor pipe required no.....
Projected Total Depth 4650..... feet
Formation..... Mississippi.....

I certify that well will comply with K.S.A. 55-101, et seq., plus eventually plugging hole to KCC specifications.

Date 11-9-87 Signature of Operator or Agent X Title.....

For KCC Use:

Conductor Pipe Required feet; Minimum Surface Pipe Required 200 feet per Alt. (2)
This Authorization Expires 5-13-88 Approved By R.H. 11-13-87


EFFECTIVE DATE: 11-18-87

Must be filed with the K.C.C. five (5) days prior to commencing well
This card void if drilling not started within six (6) months of date received by K.C.C.

Important procedures to follow:

1. Notify District office before setting surface casing.
2. Set surface casing by circulating cement to the top.
3. File completion forms ACO-1 with K.C.C. within 90 days of well completion, following instructions on ACO-1, side 1, and including copies of wireline logs.
4. Notify District office 48 hours prior to old well workover or re-entry.
Prior to filing Intent, prepare a proposed plugging plan in case well is D & A, then obtain approval of plan when calling district office prior to setting surface pipe.
6. Submit plugging report (CP-4) to K.C.C. after plugging is completed.
7. Obtain an approved injection docket number before disposing of salt water.
8. Notify K.C.C. within 10 days when injection commences or terminates.
9. If an alternate 2 completion, cement in the production pipe from below any usable water to surface within 120 days of spud date.

**A Regular Section of Land
1 Mile = 5,280 Ft.**

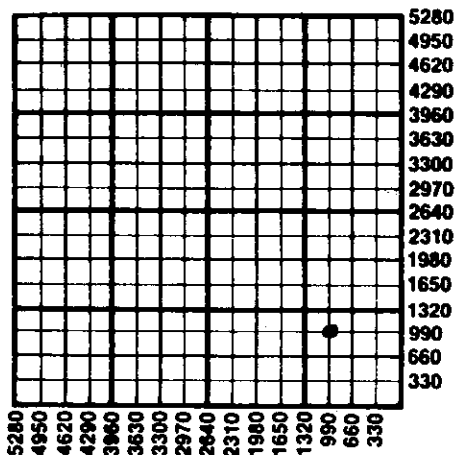

State Corporation Commission of Kansas
Conservation Division
200 Colorado Derby Building
Wichita, Kansas 67202
(316) 263-3238