

CARD MUST BE TYPED

State of Kansas  
**NOTICE OF INTENTION TO DRILL**

CARD MUST BE SIGNED

(see rules on reverse side)

Starting Date: .....2-5-85.....  
month day year

API Number 15- 101-21123-0000

OPERATOR: License # .....5422.....

. SW . SW . NE Sec .3. . Twp .17. S, Rge .29.  East  
(location)  West

Name .....Abercrombie Drilling, Inc.....

Address .....801 Union Center.....

City/State/Zip .....Wichita, KS...67202.....

Contact Person .....Jack L. Partridge.....

Phone .....316-262-1841.....

.....2970..... Ft North from Southeast Corner of Section

.....2310..... Ft West from Southeast Corner of Section

(Note: Locate well on Section Plat on reverse side)

CONTRACTOR: License # .....5422.....

Nearest lease or unit boundary line .....2310..... feet.

County .....Lane.....

Name .....Abercrombie Drilling, Inc.....

Lease Name .....Munsell..... Well# .....3.....

City/State .....Wichita, KS...67202.....

Domestic well within 330 feet :  yes  no

Well Drilled For: Well Class: Type Equipment:

Municipal well within one mile :  yes  no

Oil  Swd  Infield  Mud Rotary

Depth to Bottom of fresh water .....162..... feet

Gas  Inj  Pool Ext.  Air Rotary

Lowest usable water formation .....Dakota.....

OWWO  Expl  Wildcat  Cable

Depth to Bottom of usable water .....1100..... feet

If OWWO: old well info as follows:

Surface pipe by Alternate : 1  2

Operator .....

Surface pipe to be set .....300..... feet

Well Name .....

Conductor pipe if any required ...None..... feet

Comp Date ..... Old Total Depth .....

Ground surface elevation ..... feet MSL.

Projected Total Depth .....4600..... feet

This Authorization Expires .....7-24-85.....

Projected Formation at TD .....Lansing/KC.....

Approved By .....1-24-85.....

Expected Producing Formations .....Lansing/KC.....

I certify that we will comply with K.S.A. 55-101, et seq., plus eventually plugging hole to K.C.C. specifications.

Date ...1-23-85. Signature of Operator or Agent .....

*Jack L. Partridge*  
Jack L. Partridge


Title V.P. Abercrombie Drilling

Form C-1 4/84

MHC-1404E 1-24-85

Must be filed with the K.C.C. five (5) days prior to commencing well  
This card void if drilling not started within six (6) months of date received by K.C.C.

**A Regular Section of Land**  
1 Mile = 5,280 Ft.

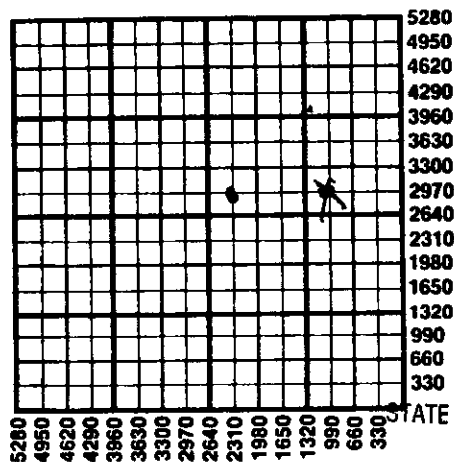

- Important procedures to follow :**
1. Notify District office before setting surface casing.
  2. Set surface casing by circulating cement to the top.
  3. File completion forms ACO-1 with K.C.C. within 90 days of well completion, following instructions on ACO-1, side 1, and including copies of wireline logs.
  4. Notify District office 48 hours prior to old well workover or re-entry.
  5. Prior to plugging, prepare a plugging plan, then obtain agreement from the appropriate district office for an approved plugging plan.
  6. Submit plugging report (CP-4) to K.C.C. after plugging is completed.
  7. Obtain an approved injection docket number before disposing of salt water.
  8. Notify K.C.C. within 10 days when injection commences or terminates.
  9. If an alternate 2 completion, cement in the production pipe from below any usable water to surface within 120 days of spud date.

RECEIVED  
STATE CORPORATION COMMISSION

JAN 24 1985

CONSERVATION DIVISION  
Wichita, Kansas

State Corporation Commission of Kansas  
Conservation Division  
200 Colorado Derby Building  
Wichita, Kansas 67202  
(316) 263-3238