

CARD MUST BE TYPED

State of Kansas
NOTICE OF INTENTION TO DRILL
(see rules on reverse side)

CARD MUST BE SIGNED

Starting Date: April 9, 1985
month day year

API Number 15- 101-21,157-0000

OPERATOR: License # 5010
Name Knighton Oil Company, Inc.
Address 207 Petroleum Building
City/State/Zip Wichita, Kansas 67202
Contact Person Earl M. Knighton, Jr.
Phone (316) 264-7918

NE NW SW Sec 3 Twp 17 S, Rge 29
(location) East West

2,310 Ft North from Southeast Corner of Section
4,290 Ft West from Southeast Corner of Section
(Note: Locate well on Section Plat on reverse side)

CONTRACTOR: License # 5381
Name Big Springs Drilling, Inc.
City/State Wichita, Kansas 67208

Nearest lease or unit boundary line 330 feet.
County Lane
Lease Name Fullmer Well# 2

Well Drilled For: Well Class: Type Equipment:
 Oil Swd Infield Mud Rotary
 Gas Inj Pool Ext. Air Rotary
 OWWO Expl Wildcat Cable

Domestic well within 330 feet: yes no
Municipal well within one mile: yes no

If OWWO: old well info as follows:

Operator
Well Name
Comp Date Old Total Depth
Projected Total Depth 4,600 feet
Projected Formation at TD Mississippian
Expected Producing Formations Lansing, Cherokee

Depth to Bottom of fresh water 165 feet
Lowest usable water formation Dakota
Depth to Bottom of usable water 1,100 feet
Surface pipe by Alternate: 1 2
Surface pipe to be set 340 feet
Conductor pipe if any required N/r feet
Ground surface elevation 2,800 feet MSL
This Authorization Expires 10-4-85
Approved By 4-4-85 [Signature]

I certify that we will comply with K.S.A. 55-101, et seq., plus eventually plugging hole to K.C.C. specifications.

Date 4/04/85 Signature of Operator or Agent

[Signature of Earl M. Knighton, Jr.]
Earl M. Knighton, Jr.

Title President Form C-1 4/84

21 MC/40HE 4-4-85

Must be filed with the K.C.C. five (5) days prior to commencing well
This card void if drilling not started within six (6) months of date received by K.C.C.


Wichita, Kansas
CONSERVATION DIVISION

APR 4 1985

RECEIVED
DIVISION OF LAND AND WATER RESOURCES
APR 10 1985

Important procedures to follow :

1. Notify District office before setting surface casing.
2. Set surface casing by circulating cement to the top.
3. File completion forms ACO-1 with K.C.C. within 90 days of well completion, following instructions on ACO-1, side 1, and including copies of wireline logs.
4. Notify District office 48 hours prior to old well workover or re-entry.
5. Prior to plugging, prepare a plugging plan, then obtain agreement from the appropriate district office for an approved plugging plan.
6. Submit plugging report (CP-4) to K.C.C. after plugging is completed.
7. Obtain an approved injection docket number before disposing of salt water.
8. Notify K.C.C. within 10 days when injection commences or terminates.
9. If an alternate 2 completion, cement in the production pipe from below any usable water to surface within 120 days of spud date.

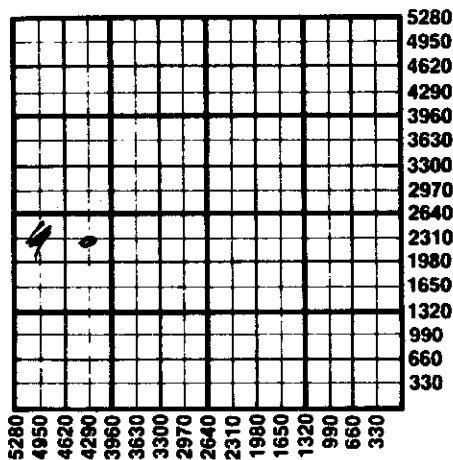

**State Corporation Commission of Kansas
Conservation Division
200 Colorado Derby Building
Wichita, Kansas 67202
(316) 263-3238**