

SIDE ONE

STATE CORPORATION COMMISSION OF KANSAS
OIL & GAS CONSERVATION DIVISION
WELL COMPLETION OR RECOMPLETION FORM
ACO-1 WELL HISTORY
DESCRIPTION OF WELL AND LEASE

Operator: License # 4767
Name Ritchie Exploration, Inc.
Address 125 N. Market, Suite 1000
City/State/Zip Wichita, KS 67202

Purchaser Koch Oil Co.
Wichita, KS

Operator Contact Person Rocky Milford
Phone 316/267-4375

Contractor: License # 6033
Name Murfin Drilling Co.

Wellsite Geologist Bob Mathiesen
Phone 316/267-4375

Designate Type of Completion
 New Well Re-Entry Workover

Oil SWD Temp Abd
 Gas Inj Delayed Comp.
 Dry Other (Core, Water Supply etc.)

If OWNO: old well, info as follows:
Operator
Well Name
Comp. Date
Old Total Depth

WELL HISTORY

Drilling Method:
 Mud Rotary Air Rotary Cable
12/21/88 12/31/88 1/21/89
Spud Date Date Reached TD Completion Date
4880' n/a
Total Depth PBTD

Amount of Surface Pipe Set and Cemented at 218 feet
Multiple Stage Cementing Collar Used? Yes No
If yes, show depth set 1892' feet
If alternate 2 completion, cement circulated
from 1892' feet depth to surface / 363 SX cmt
Cement Company Name Allied Cementing Co.
Invoice # 53299
4-4-89

API NO. 15-101-21,497-0000
County Lane
100 W of East
N/2 NE NW Sec. 22 Twp. 20 Rge. 27, XX West

4950 Ft North from Southeast Corner of Section
3400 Ft West from Southeast Corner of Section
(Note: Locate well in section plat below)


Lease Name Burnett-22B Well # 1

Field Name Witt

Producing Formation Mississippi

Elevation: Ground 2594' KB 2590'

Section Plat

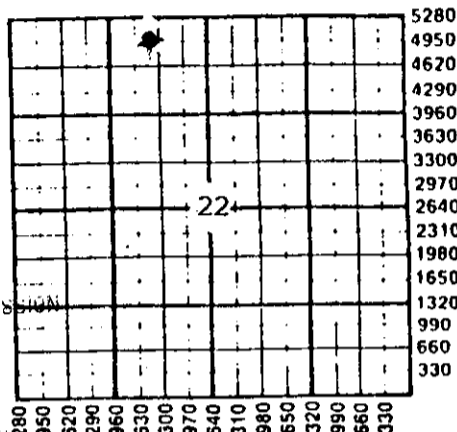

PLEASE KEEP THIS
INFORMATION
CONFIDENTIAL

RECEIVED
STATE CORPORATION COMMISSION
3-30-89
MAR 30 1989

WATER SUPPLY INFORMATION
Disposition of Produced Water: Disposal
Docket # D-25648 Repressuring

Questions on this portion of the ACO-1 call:
Water Resources Board (913) 296-3717
Source of Water: Hauled
Division of Water Resources Permit #
 Groundwater.....Ft North from Southeast Corner
(Well)Ft West from Southeast Corner of
Sec Twp Rge East West
 Surface Water.....Ft North from Southeast Corner
(Stream,pond etc).....Ft West from Southeast Corner
Sec Twp Rge East West
 Other (explain).....
(purchased from city, R.W.D. #)

INSTRUCTIONS: This form shall be completed in triplicate and filed with the Kansas Corporation Commission, 200 Colorado Derby Building, Wichita, Kansas 67202, within 120 days of the spud date of any well. Rule 82-3-130, 82-3-107 and 82-3-106 apply. Information on side two of this form will be held confidential for a period of 12 months if requested in writing and submitted with the form. See rule 82-3-107 for confidentiality in excess of 12 months. One copy of all wireline logs and drillers time log shall be attached with this form. Submit CP-4 form with all plugged wells. Submit CP-111 form with all temporarily abandoned wells.

All requirements of the statutes, rules and regulations promulgated to regulate the oil and gas industry have been fully complied with and the statements herein are complete and correct to the best of my knowledge.

Signature [Signature]
Title Vice President Date 3/20/89

Subscribed and sworn to before me this 20th day of March
1989
Notary Public Linda K. Rice
Date Commission Expires 6-7-92

LINDA K. RICE
NOTARY PUBLIC
STATE OF KANSAS
My Appt. Exp. 6-7-92

K.C.C. OFFICE USE ONLY
 Letter of Confidentiality Attached
 Wireline Log Received
 Drillers Time Log Received
Distribution
 KCC SWD/Rep NGPA
 KGS Plug Other
(Specify)
3-30-89

Form ACO-1 (5-86)

Sec 20 Twp 20 Rge 27 E