

CARD MUST BE TYPED

State of Kansas
NOTICE OF INTENTION TO DRILL
(see rules on reverse side)

CARD MUST BE SIGNED

Starting Date: 10 10 84
month day year

API Number 15- 101-21,041-0000

OPERATOR: License # 9746

CN/2 S/2 SE/4 Sec 36.. Twp 18 S, Rge 29. East
(location) West

Name Wilkar Oil Company

Address P.O. Box 3225

City/State/Zip Santa Fe Springs, CA 90670

Contact Person Charles Ed Harris

Phone (316) 265-9524

990 Ft North from Southeast Corner of Section

1320 Ft West from Southeast Corner of Section

(Note: Locate well on Section Plat on reverse side)

CONTRACTOR: License #

Name Unknown

City/State

Nearest lease or unit boundary line 1320 feet.

County Lane

Lease Name D. E. Stanley Well# 1

Well Drilled For: Well Class: Type Equipment:

- | | | | |
|---|-------------------------------|---|--|
| <input checked="" type="checkbox"/> Oil | <input type="checkbox"/> Swd | <input type="checkbox"/> Infield | <input checked="" type="checkbox"/> Mud Rotary |
| <input type="checkbox"/> Gas | <input type="checkbox"/> Inj | <input type="checkbox"/> Pool Ext. | <input type="checkbox"/> Air Rotary |
| <input type="checkbox"/> OWWO | <input type="checkbox"/> Expl | <input checked="" type="checkbox"/> Wildcat | <input type="checkbox"/> Cable |

Domestic well within 330 feet: yes no

Municipal well within one mile: yes no

If OWWO: old well info as follows:

Operator

Well Name

Comp Date Old Total Depth

Projected Total Depth 4650 feet

Projected Formation at TD Mississippian

Expected Producing Formations LKC Marmaton Cher

Depth to Bottom of fresh water 60 feet

Lowest usable water formation Dakota

Depth to Bottom of usable water 900-1025 feet

Surface pipe by Alternate: 1 2

Surface pipe to be set 200 feet

Conductor pipe if any required feet

Ground surface elevation feet MSI.

This Authorization Expires 3-5-85

Approved By 9-5-84

I certify that we will comply with K.S.A. 55-101, et seq., plus eventually plugging hole to K.C.C. specifications.

Date 9/5/84 Signature of Operator or Agent

Charles Ed Harris

Title District Manager


MHC/WOHE 9/5/84 Form C-1 4/84

Must be filed with the K.C.C. five (5) days prior to commencing well
This card void if drilling not started within six (6) months of date received by K.C.C.

SEP 5 1984
9-5-84
WICHITA, KANSAS

Important procedures to follow:

**A Regular Section of Land
1 Mile = 5,280 Ft.**

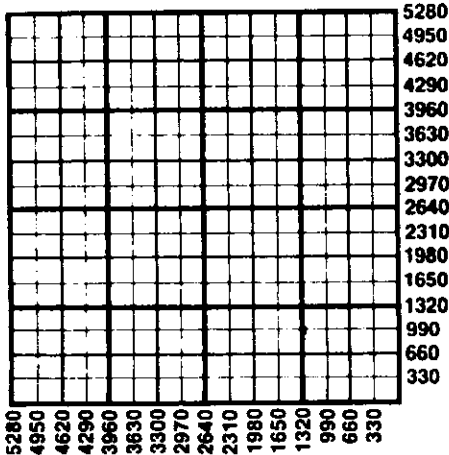

1. Notify District office before setting surface casing.
2. Set surface casing by circulating cement to the top.
3. File completion forms ACO-1 with K.C.C. within 90 days of well completion, following instructions on ACO-1, side 1, and including copies of wireline logs.
4. Notify District office 48 hours prior to old well workover or re-entry.
5. Prior to plugging, prepare a plugging plan, then obtain agreement from the appropriate district office for an approved plugging plan.
6. Submit plugging report (CP-4) to K.C.C. after plugging is completed.
7. Obtain an approved injection docket number before disposing of salt water.
8. Notify K.C.C. within 10 days when injection commences or terminates.
9. If an alternate 2 completion, cement in the production pipe from below any usable water to surface within 120 days of spud date.

**State Corporation Commission of Kansas
Conservation Division
200 Colorado Derby Building
Wichita, Kansas 67202
(316) 263-3238**