

CARD MUST BE TYPED

State of Kansas
NOTICE OF INTENTION TO DRILL
 (see rules on reverse side)

CARD MUST BE SIGNED

Starting Date: 6 - 29 - 84
 month day year

API Number 15-

101-20,997-0000

OPERATOR: License # 5053

SE NE SW ... Sec 10 Twp 18 S, Rge 29
 (location)

☐ East☒ West

Name PETRO-DYNAMICS CORPORATION

Address 555 N. Woodlawn Bldg. 1 Suite 207

City/State/Zip Wichita, KS 67208

Contact Person Vern Brundgardt

Phone 316-681-1685

CONTRACTOR: License # 5889

Name KANDRILCO, Inc.

City/State Wichita, KS

Well Drilled For: Well Class: Type Equipment:

☒ Oil ☐ Swd ☐ Infield ☒ Mud Rotary☐ Gas ☐ Inj ☐ Pool Ext. ☐ Air Rotary☐ OWWO ☐ Expl ☒ Wildcat ☐ Cable

If OWWO: old well info as follows:

Operator

Well Name

Comp Date Old Total Depth

Projected Total Depth 4650 feet

Projected Formation at TD Mississippian

Expected Producing Formations Mississippian

1650 Ft North from Southeast Corner of Section

2970 Ft West from Southeast Corner of Section

(Note: Locate well on Section Plat on reverse side)

Nearest lease or unit boundary line 330 feet

County Lane

Lease Name McKenna Well # 1

Domestic well within 330 feet: ☐ yes ☒ noMunicipal well within one mile: ☐ yes ☒ no

Depth to Bottom of fresh water 110 feet

Lowest usable water formation Dakota

Depth to Bottom of usable water 1050 feet

Surface pipe by Alternate: 1 ☐ 2 ☒

Surface pipe to be set 200 feet

Conductor pipe if any required feet

Ground surface elevation feet MSL

This Authorization Expires 12-19-84

Approved By 6-19-84

I certify that we will comply with K.S.A. 55-101, et seq., plus eventually plugging hole to K.C.C. specifications.

Date 6-19-84 Signature of Operator or Agent

Title Manager

Form C-1 4/84


MHC/MOHE 6-19-84

Must be filed with the K.C.C. five (5) days prior to commencing well
This card void if drilling not started within six (6) months of date received by K.C.C.

RECEIVED
STATE CORPORATION COMMISSION
JUN 9 1984
6-19-84
Regular Section of Land
Mile = 5280 Ft.
Conservation Division
Wichita, Kansas

Important procedures to follow :

1. Notify District office before setting surface casing.
2. Set surface casing by circulating cement to the top.
3. File completion forms ACO-1 with K.C.C. within 90 days of well completion, following instructions on ACO-1, side 1, and including copies of wireline logs.
4. Notify District office 48 hours prior to old well workover or re-entry.
5. Prior to plugging, prepare a plugging plan, then obtain agreement from the appropriate district office for an approved plugging plan.
6. Submit plugging report (CP-4) to K.C.C. after plugging is completed.
7. Obtain an approved injection docket number before disposing of salt water.
8. Notify K.C.C. within 10 days when injection commences or terminates.
9. If an alternate 2 completion, cement in the production pipe from below any usable water to surface within 120 days of spud date.

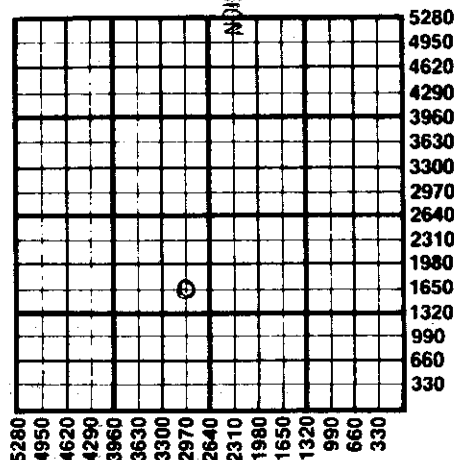

State Corporation Commission of Kansas
Conservation Division
200 Colorado Derby Building
Wichita, Kansas 67202
(316) 263-3238