

CARD MUST BE TYPED

State of Kansas
NOTICE OF INTENTION TO DRILL

CARD MUST BE SIGNED

(see rules on reverse side)

Starting Date: 4 10 85
 month day year

API Number 15- 101-21,159-0000

OPERATOR: License # 5123

NE SE NW Sec 18 Twp 18 S, Rge 29
(location) East West

Name Pickrell Drilling Company

Address 110 N. Market, Suite 205

City/State/Zip Wichita, KS 67202

Contact Person Jay McNeil

Phone (316) 262-8427

3630 Ft North from Southeast Corner of Section

2970 Ft West from Southeast Corner of Section

(Note: Locate well on Section Plat on reverse side)

CONTRACTOR: License # 5123

Nearest lease or unit boundary line 330 feet.

County Lane

Name Pickrell Drilling Company

Lease Name Riley Well# 1-F

City/State Wichita, Kansas

Domestic well within 330 feet: yes no

Well Drilled For: Well Class: Type Equipment:

Municipal well within one mile: yes no

Oil Swd Infield Mud Rotary

Depth to Bottom of fresh water 180 feet

Gas Inj Pool Ext. Air Rotary

Lowest usable water formation Dakota

OWWO Expl Wildcat Cable

Depth to Bottom of usable water 500-1050 feet

If OWWO: old well info as follows:

Surface pipe by Alternate: 1 2 300+

Operator

Surface pipe to be set feet

Well Name

Conductor pipe if any required feet

Comp Date Old Total Depth

Ground surface elevation 2836 feet MSI.

Projected Total Depth 4650 feet

This Authorization Expires 10-8-85

Projected Formation at TD Miss.

Approved By RCH/KCC 4-8-85

Expected Producing Formations Penn-Miss.

I certify that we will comply with K.S.A. 55-101, et seq., plus eventually plugging hole to K.C.C. specifications.

Date 4-8-85 Signature of Operator or Agent

Title Chief Geologist


MHC/UDHE 4-9-85

Must be filed with the K.C.C. five (5) days prior to commencing well
This card void if drilling not started within six (6) months of date received by K.C.C.

RECEIVED
STATE CORPORATION COMMISSION

4-8-85
APR 8 1985

A Regular Section of Land
1 Mile ~~75.280~~ Acres

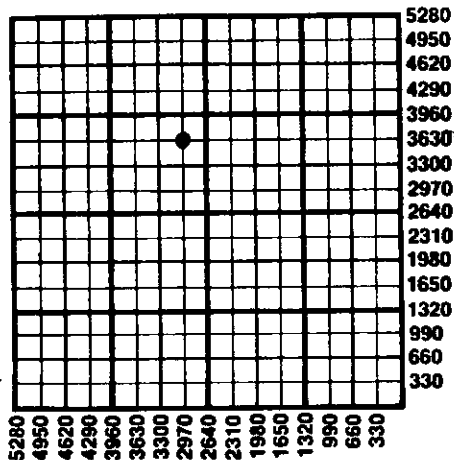

Important procedures to follow:

1. Notify District office before setting surface casing.
2. Set surface casing by circulating cement to the top.
3. File completion forms ACO-1 with K.C.C. within 90 days of well completion, following instructions on ACO-1, side 1, and including copies of wireline logs.
4. Notify District office 48 hours prior to old well workover or re-entry.
5. Prior to plugging, prepare a plugging plan, then obtain agreement from the appropriate district office for an approved plugging plan.
6. Submit plugging report (CP-4) to K.C.C. after plugging is completed.
7. Obtain an approved injection docket number before disposing of salt water.
8. Notify K.C.C. within 10 days when injection commences or terminates.
9. If an alternate 2 completion, cement in the production pipe from below any usable water to surface within 120 days of spud date.

State Corporation Commission of Kansas
Conservation Division
200 Colorado Derby Building
Wichita, Kansas 67202
(316) 263-3238