

NOTICE OF INTENTION TO DRILL

(see rules on reverse side)

Starting Date 3 25 86
month day year 3/42

API Number 15- 101-21,305-0000

OPERATOR: License # 5886
Name Chief Drilling Co., Inc.
Address 151 N. Main #700 Wichita, Ks. 67202
City/State/Zip

SE SE NW Sec. 1 Twp. 18 S, Rg. 30 X West
2970 Ft. from South Line of Section
2970 Ft. from East Line of Section

(Note: Locate well on Section Plat on reverse side)

Contact Person Douglas W. Thimsech
Phone 316-262-3791

Nearest lease or unit boundary line 330 feet
County Lane

CONTRACTOR: License # 5883
Name Warrior Drilling Co.
City/State Wichita, Kansas

Lease Name Cramer Well # 1
Ground surface elevation will provide feet MSL

Well Drilled For: Well Class: Type Equipment:
X Oil SWD Infield X Mud Rotary
Gas Inj Pool Ext Air Rotary
OWWO Expl Wildcat Cable

Domestic well within 330 feet: yes X no
Municipal well within one mile: yes X no

If OWWO: old well info as follows:

Operator
Well Name
Comp Date Old Total Depth

Surface pipe by Alternate: 1 2 X
Depth to bottom of fresh water 150
Depth to bottom of usable water 1300
Surface pipe planned to be set 300
Projected Total Depth 4600 feet
Formation Miss.

I certify that well will comply with K.S.A. 55-101, et seq., plus eventually plugging hole to KCC specifications.

_____ cementing will be done immediately upon setting production casing.
Date 3-24-86 Signature of Operator or Agent Douglas W. Thimsech Title Vice President

For KCC Use:

Conductor Pipe Required feet; Minimum Surface Pipe Required 250 feet per AL

This Authorization Expires 3-24-86 Approved By

Handwritten signature/initials

Handwritten signature/initials

Must be filed with the K.C.C. five (5) days prior to commencing well
This card void if drilling not started within six (6) months of date received by K.C.C.


Important procedures to follow:

1. Notify District office before setting surface casing.
2. Set surface casing by circulating cement to the top.
3. File completion forms ACO-1 with K.C.C. within 90 days of well completion, following instructions on ACO-1, side 1, and including copies of wireline logs.
4. Notify District office 48 hours prior to old well workover or re-entry.
5. Prior to filing Intent, prepare a proposed plugging plan in case well is D & A, then obtain approval of plan when calling district office prior to setting surface pipe.
6. Submit plugging report (CP-4) to K.C.C. after plugging is completed.
7. Obtain an approved injection docket number before disposing of salt water.
8. Notify K.C.C. within 10 days when injection commences or terminates.
9. If an alternate 2 completion, cement in the production pipe from below any usable water to surface within 120 days of spud date.

RECEIVED
STATE CORPORATION COMMISSION

A Regular Section of Land
1 Mile = 5,280 Ft.

MAR 24 1986
3-24-86
CONSERVATION DIVISION
Wichita, Kansas

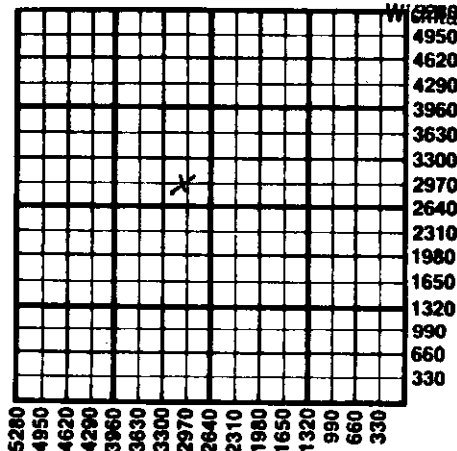

State Corporation Commission of Kansas
Conservation Division
200 Colorado Derby Building
Wichita, Kansas 67202
(316) 263-3238