

CARD MUST BE TYPED

State of Kansas

CARD MUST BE SIGNED

NOTICE OF INTENTION TO DRILL

(see rules on reverse side)

Starting Date October 24 1987
month day yearOPERATOR: License # 9152 & 8541
Name MAREXCO & PETEX, Inc.
Address P. O. Box 706
City/State/Zip Edmond, OK 73083
Contact Person Stephen W. Marden
Phone (405) 340-6387CONTRACTOR: License # 9087
Name R. & C. Drilling, Inc.
City/State Hays, KansasWell Drilled For: Well Class: Type Equipment:
— Oil — SWD — Infield ☒ Mud Rotary
— Gas — Inj — Pool Ext. — Air Rotary
☒ OWWO — Expl ☒ Wildcat — Cable

If OWWO: old well info as follows:

Operator Osborn Heirs Company
Well Name Delmar Whiting #1
Comp Date 6/23/85 Old Total Depth 4640

I certify that well will comply with K.S.A. 55-101, et seq., plus eventually plugging hole to KCC specifications.

_____ cementing will be done immediately upon setting production casing
Date 10/14/87 Signature of Operator or Agent Stephen W. Marden Title Sale Proprietor

For KCC Use:

Conductor Pipe Required feet Minimum Surface Pipe Required 217 feet per Alt. ☒ 2
This Authorization Expires 4-21-88 Effective 10-21-87 Approved By RCH 10-21-87API Number 15—101-21,177-A0001
SE. SW. SE. Sec. 31... Twp. 18. S, Rg. 30... ☒ East
330 Ft. from South Line of Section
1650 Ft. from East Line of Section

(Note: Locate well on Section Plat on reverse side)


Nearest lease or unit boundary line 330 feet
County Lane
Lease Name... Delmar Whiting Well #... 1
Ground surface elevation 2899 feet MSL
Domestic well within 330 feet: — yes ☒ no
Municipal well within one mile: — yes ☒ no
Surface pipe by Alternate: Already set 1 2
Depth to bottom of fresh water 250 100
Depth to bottom of usable water 1300 1500
Surface pipe planned to be set 217' already set
Projected Total Depth 4640 feet
Formation Mississippian

Must be filed with the K.C.C. five (5) days prior to commencing well
This card void if drilling not started within six (6) months of date received by K.C.C.

Important procedures to follow:

1. Notify District office before setting surface casing.
2. Set surface casing by circulating cement to the top.
3. File completion forms ACO-1 with K.C.C. within 90 days of well completion, following instructions on ACO-1, side 1, and including copies of wireline logs.
4. Notify District office 48 hours prior to old well workover or re-entry.
5. Prior to filing Intent, prepare a proposed plugging plan in case well is D & A, then obtain approval of plan when calling district office prior to setting surface pipe.
6. Submit plugging report (CP-4) to K.C.C. after plugging is completed.
7. Obtain an approved injection docket number before disposing of salt water.
8. Notify K.C.C. within 10 days when injection commences or terminates.
9. If an alternate 2 completion, cement in the production pipe from below any usable water to surface within 120 days of spud date.

A Regular Section of Land 1 Mile = 5,280 Ft.

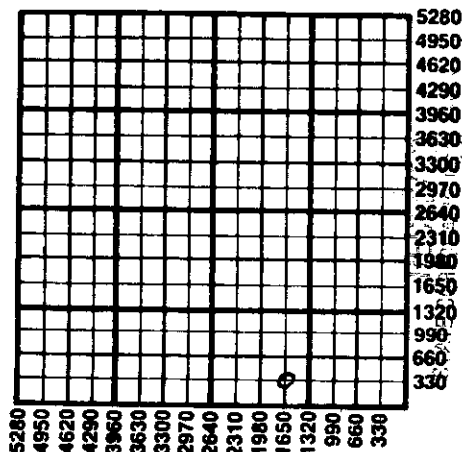

CCT 21 1987
10-21-87
Conservation Division
Wichita, Kansas

State Corporation Commission of Kansas
Conservation Division
200 Colorado Derby Building
Wichita, Kansas 67202
(316) 263-3238