

CARD MUST BE TYPED

State of Kansas
NOTICE OF INTENTION TO DRILL

(see rules on reverse side)

CARD MUST BE SIGNED

Starting Date: 6 21 85
month day year

API Number 15- 101-21,187-0000

OPERATOR: License # 5107
Name H-30, Inc.
Address 251 North Water, Suite 10
City/State/Zip Wichita, KS 67202
Contact Person Dean Britting
Phone (316) 263-2043

300' S 72° E 1/2 NE SE Sec 2 Twp 20 S, Rge 29 East West
(location)

251 Ft North from Southeast Corner of Section
100 Ft West from Southeast Corner of Section
(Note: Locate well on Section Plat on reverse side)

CONTRACTOR: License # 5107
Name H-30, Inc.
City/State Wichita, KS

Nearest lease or unit boundary line 100 feet.
County Lane
Lease Name McCoy Well # 2

Domestic well within 330 feet: yes no
Municipal well within one mile: yes no

Well Drilled For: Well Class: Type Equipment:
 Oil Swd Infield Mud Rotary
 Gas Inj Pool Ext. Air Rotary
 OWWO Expl Wildcat Cable

Depth to Bottom of fresh water 80 feet
Lowest usable water formation Dakota
Depth to Bottom of usable water 1000 feet
Surface pipe by Alternate: 1 2000
Surface pipe to be set 2000 feet
Conductor pipe if any required _____ feet
Ground surface elevation _____ feet MSL

If OWWO: old well info as follows:
Operator _____
Well Name _____
Comp Date _____ Old Total Depth _____
Projected Total Depth 2000 feet
Projected Formation at TD Cedar Hills
Expected Producing Formations n/a

This Authorization Expires 12-18-85
Approved By 6-18-85 MHC/NOHE
Agent 6-18-85


I certify that we will comply with K.S.A. 55-101, et seq., plus eventually plugging hole to K.C.C. specifications.

Date 6/18/85 Signature of Operator or Agent Jessica Quinton Title Agent

Must be filed with the K.C.C. five (5) days prior to commencing well
This card void if drilling not started within six (6) months of date received by K.C.C.

Important procedures to follow :

A Regular Section of Land
1 Mile = 5,280 Ft.

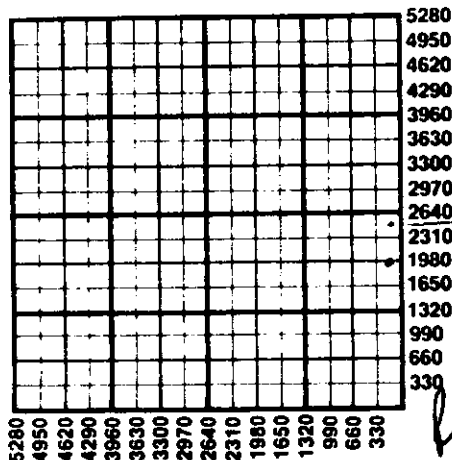

1. Notify District office before setting surface casing.
2. Set surface casing by circulating cement to the top.
3. File completion forms ACO-1 with K.C.C. within 90 days of well completion, following instructions on ACO-1, side 1, and including copies of wireline logs.
4. Notify District office 48 hours prior to old well workover or re-entry.
5. Prior to plugging, prepare a plugging plan, then obtain agreement from the appropriate district office for an approved plugging plan.
6. Submit plugging report (CP-4) to K.C.C. after plugging is completed.
7. Obtain an approved injection docket number before disposing of salt water.
8. Notify K.C.C. within 10 days when injection commences or terminates.
9. If an alternate 2 completion, cement in the production pipe from below any usable water to surface within 120 days of spud date.

State Corporation Commission of Kansas
Conservation Division
200 Colorado Derby Building
Wichita, Kansas 67202
(316) 263-3238