

CARD MUST BE TYPED

State of Kansas  
**NOTICE OF INTENTION TO DRILL**  
(see rules on reverse side)

CARD MUST BE SIGNED

Starting Date: April 30, 1985  
month day year

API Number 15- 135-22,802-00-00

OPERATOR: License # 5104  
Name Blue Goose Drilling Company, Inc.  
Address P.O. Box 1413  
City/State/Zip Great Bend, KS 67530  
Contact Person Martin E. Miller  
Phone 316 792-5633

NE NE SE... See 1 Twp 20 S, Rge 26.  
(location)  East  West

2310 Ft North from Southeast Corner of Section  
330 Ft West from Southeast Corner of Section  
(Note: Locate well on Section Plat on reverse side)

CONTRACTOR: License #  
Name Company Tools  
City/State

Nearest lease or unit boundary line 330 feet.  
County Ness  
Lease Name Betz Well# 1

Well Drilled For: Well Class: Type Equipment:  
 Oil  Swd  Infield  Mud Rotary  
 Gas  Inj  Pool Ext.  Air Rotary  
 OWWO  Expl  Wildeat  Cable

Domestic well within 330 feet:  yes  no  
Municipal well within one mile:  yes  no

If OWWO: old well info as follows:

Operator  
Well Name  
Comp Date Old Total Depth  
Projected Total Depth 4550 feet  
Projected Formation at TD Mississippi  
Expected Producing Formations Miss Cher Sd.

Depth to Bottom of fresh water ..... feet  
Lowest usable water formation Dakota ..... feet  
Depth to Bottom of usable water 700 ..... feet  
Surface pipe by Alternate:  1  2  
Surface pipe to be set 800 ..... feet  
Conductor pipe if any required ..... feet  
Ground surface elevation ..... feet MSL.  
This Authorization Expires 10-5-85  
Approved By RCM/KCC 4-5-85

I certify that we will comply with K.S.A. 55-101, et seq., plus eventually plugging hole to K.C.C. specifications.

Date 4/4/85 Signature of Operator or Agent Martin E. Miller Title

CONTRACT REPRESENTATIVE


Form C-1 4/84

KOD-KDHE 4S-85

Must be filed with the K.C.C. five (5) days prior to commencing well  
 This card void if drilling not started within six (6) months of date received by K.C.C.

Important procedures to follow: RECEIVED  
 STATE CORPORATION COMMISSION

A Regular Section of Land  
 1 Mile = 5,280 Ft.

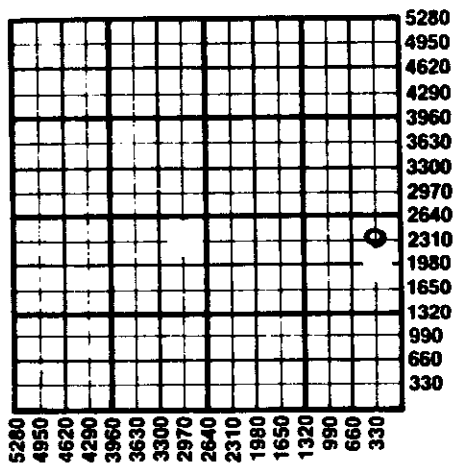

1. Notify District office before setting surface casing.
2. Set surface casing by circulating cement to the top.
3. File completion forms ACO-1 with K.C.C. within 90 days of well completion, following instructions on ACO-1, side 1, and including copies of wireline logs.
4. Notify District office 48 hours prior to old well workover or re-entry.
5. Prior to plugging, prepare a plugging plan, then obtain agreement from the appropriate district office for an approved plugging plan.
6. Submit plugging report (CP-4) to K.C.C. after plugging is completed.
7. Obtain an approved injection docket number before disposing of salt water.
8. Notify K.C.C. within 10 days when injection commences or terminates.
9. If an alternate 2 completion, cement in the production pipe from below any usable water to surface within 120 days of spud date.

APR 05 1985  
 04-05-1985  
 CONSERVATION DIVISION  
 WICHITA, KANSAS

State Corporation Commission of Kansas  
 Conservation Division  
 200 Colorado Derby Building  
 Wichita, Kansas 67202  
 (316) 263-3238