

CARD MUST BE TYPED

State of Kansas
NOTICE OF INTENTION TO DRILL

CARD MUST BE SIGNED

(see rules on reverse side)

Starting Date: September 15 1984
month day year

API Number 15- 007-21,923-0000

OPERATOR: License # 5050
Name Hummon Corporation
Address 400 One Main Place
City/State/Zip Wichita, KS 67202
Contact Person Wilber Berg
Phone 263-8521

.C... SW .SE Sec .36 Twp 31 . S, Rge .11. East
(location) West

...660... Ft North from Southeast Corner of Section
..1980... Ft West from Southeast Corner of Section
(Note: Locate well on Section Plat on reverse side)

CONTRACTOR: License # 5148
Name Big-H Drilling, Inc.
City/State Wichita, Kansas

Nearest lease or unit boundary line660..... feet.
County Barber

Lease Name Chapin Well# 5-36.....
Domestic well within 330 feet : yes no
Municipal well within one mile : yes no

Well Drilled For: Well Class: Type Equipment:
 Oil Swd Infield Mud Rotary
 Gas Inj Pool Ext. Air Rotary
 OWWO Expl Wildcat Cable

Depth to Bottom of fresh water ..100..... feet
Lowest usable water formation ..Salt Plain Slt.....

If OWWO: old well info as follows:
Operator
Well Name
Comp Date Old Total Depth
Projected Total Depth ..3875..... feet
Projected Formation at TD ..Lansing.....
Expected Producing Formations

Depth to Bottom of usable water200..... feet
Surface pipe by Alternate : 1 2

Surface pipe to be set200..... feet
Conductor pipe if any required feet

Ground surface elevation feet MSL
This Authorization Expires ..3-19-85.....

Approved By [Signature]

I certify that we will comply with K.S.A. 55-101, et seq., plus eventually plugging hole to K.C.C. specifications.


Date 9-7-84 Signature of Operator or Agent [Signature] Title President

MHC/UDHE 9/10/84

Must be filed with the K.C.C. five (5) days prior to commencing well
This card void if drilling not started within six (6) months of date received by K.C.C.

Important procedures to follow :

**A Regular Section of Land
1 Mile = 5,280 Ft.**

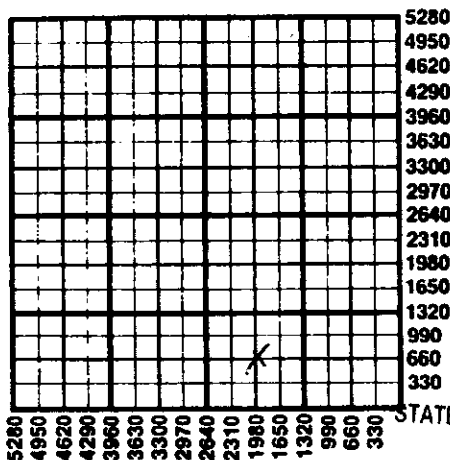

1. Notify District office before setting surface casing.
2. Set surface casing by circulating cement to the top.
3. File completion forms ACO-1 with K.C.C. within 90 days of well completion, following instructions on ACO-1, side 1, and including copies of wireline logs.
4. Notify District office 48 hours prior to old well workover or re-entry.
5. Prior to plugging, prepare a plugging plan, then obtain agreement from the appropriate district office for an approved plugging plan.
6. Submit plugging report (CP-4) to K.C.C. after plugging is completed.
7. Obtain an approved injection docket number before disposing of salt water.
8. Notify K.C.C. within 10 days when injection commences or terminates.
9. If an alternate 2 completion, cement in the production pipe from below usable water to surface within 120 days of spud date.

RECEIVED

STATE CORPORATION COMMISSION

State Corporation Commission of Kansas

Conservation Division

200 Colorado Derby Building

Wichita, Kansas 67202

(316) 263-3238

SEP 10 1984
9-10-84

CONSERVATION DIVISION
Wichita, Kansas