

NOTICE OF INTENTION TO DRILL

(see rules on reverse side)

Starting Date 8/15/86
month day yearAPI Number 15- 101-21,328-0000OPERATOR: License # 4865
Name SunTex Resources, Inc.
Address 12160 Abrams St. Suite 417
City/State/Zip Dallas, Texas 75243
Contact Person Mike Covert
Phone 214-437-1212NW. SE. SE. Sec. 29 Twp. 16 S, Rg. 27 X East
990 Ft. from South Line of Section
990 Ft. from East Line of Section

(Note: Locate well on Section Plat on reverse side)

CONTRACTOR: License # N/A
Name
City/StateNearest lease or unit boundary line 990 feet
County LaneWell Drilled For: Well Class: Type Equipment:
 Oil SWD Infield Mud Rotary
 Gas Inj Pool Ext. Air Rotary
 OWWO Expl Wildcat CableLease Name Massey Well # 1-29
Ground surface elevation 2714 feet MSL

If OWWO: old well info as follows:

Domestic well within 330 feet: yes no
Municipal well within one mile: yes noDepth to bottom of fresh water 100 ft.Depth to bottom of usable water 1,400 ft.Surface pipe by Alternate: 1 2 Surface pipe planned to be set 300 ft.Conductor pipe required NOProjected Total Depth 4,850 feetFormation Mississippian

I certify that well will comply with K.S.A. 55-101, et seq., plus eventually plugging hole to KCC specifications.

Date 8/1/86 Signature of Operator or Agent Kenneth A. Trout Title President

For KCC Use:


Conductor Pipe Required _____ feet; Minimum Surface Pipe Required _____ feet per Alt. 2This Authorization Expires 2-6-87 Approved By 8-6-86 R

Must be filed with the K.C.C. five (5) days prior to commencing well
This card void if drilling not started within six (6) months of date received by K.C.C.

Important procedures to follow:

1. Notify District office before setting surface casing.
2. Set surface casing by circulating cement to the top.
3. File completion forms ACO-1 with K.C.C. within 90 days of well completion, following instructions on ACO-1, side 1, and including copies of wireline logs.
4. Notify District office 48 hours prior to old well workover or re-entry.
5. Prior to filing Intent, prepare a proposed plugging plan in case well is D & A, then obtain approval of plan when calling district office prior to setting surface pipe.
6. Submit plugging report (CP-4) to K.C.C. after plugging is completed.
7. Obtain an approved injection docket number before disposing of salt water.
8. Notify K.C.C. within 10 days when injection commences or terminates.
9. If an alternate 2 completion, cement in the production pipe from below any usable water to surface within 120 days of spud date.

**A Regular Section of Land
1 Mile = 5,280 Ft.**

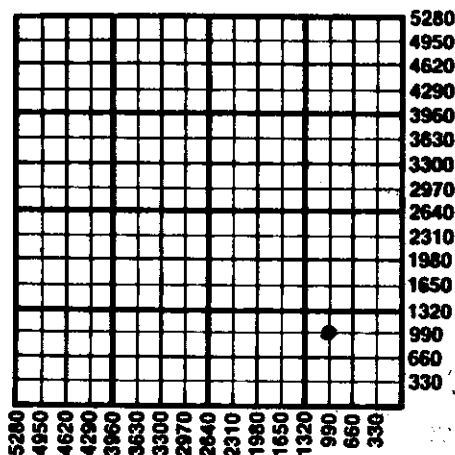

RECEIVED
STATE CORPORATION COMMISSION
WICHITA, KANSAS

8-6-86
AUG 6 1986

State Corporation Commission of Kansas
Conservation Division
200 Colorado Derby Building
Wichita, Kansas 67202
(316) 263-3238