

NOTICE OF INTENTION TO DRILL

(see rules on reverse side)

Starting Date February 16, 1987
month day year 3:38

API Number 15- 165-21,376-00-00
— East

OPERATOR: License # 4668
Name Seville Drilling Corporation
Address P. O. Box 668
City/State/Zip LaCrosse, KS 67548
Contact Person. ~~XXXXXXXXXXXX~~ D. L. Stegman
Phone ~~XXXXXXXXXXXX~~ 913-222-2633

.SE .NE .SW Sec. 23. Twp. 16. S, Rg. 17. X West
1650. Ft. from South Line of Section
2970. Ft. from East Line of Section

(Note: Locate well on Section Plat on reverse side)

CONTRACTOR: License # 4083
Name Western KS Drilling, Inc.
City/State Hays, KS

Nearest lease or unit boundary line .330. feet
County Rush

Lease Name Stramel Well # R-1
Ground surface elevation approx. 2020. feet MSL

Well Drilled For: Well Class: Type Equipment:
X Oil — SWD — Infield X Mud Rotary
X Gas — Inj — Pool Ext. — Air Rotary
— OWWO — Expl X Wildcat — Cable

Domestic well within 330 feet: —yes Xno
Municipal well within one mile: Xyes —no

If OWWO: old well info as follows:
Operator
Well Name
Comp Date Old Total Depth

Depth to bottom of fresh water. 350.
Depth to bottom of usable water 750. 550
Surface pipe by Alternate: 1 X 2 —
Surface pipe planned to be set 1180.
Conductor pipe required
Projected Total Depth 3800. feet
Formation Granite

I certify that well will comply with K.S.A. 55-101, et seq., plus eventually plugging hole to KCC specifications.
Date 2/12/87 Signature of Operator or Agent [Signature] Title AS Agent

For KCC Use:
Conductor Pipe Required feet; Minimum Surface Pipe Required 550 feet per Alt.
This Authorization Expires 8-12-87 Approved By 2-12-87 [Signature]

Red/Ken [Signature]

Must be filed with the K.C.C. five (5) days prior to commencing well
This card void if drilling not started within six (6) months of date received by K.C.C.

Important procedures to follow:


1. Notify District office before setting surface casing.
2. Set surface casing by circulating cement to the top.
3. File completion forms ACO-1 with K.C.C. within 90 days of well completion, following instructions on ACO-1, side 1, and including copies of wireline logs.
4. Notify District office 48 hours prior to old well workover or re-entry.
5. Prior to filing Intent, prepare a proposed plugging plan in case well is D & A, then obtain approval of plan when calling district office prior to setting surface pipe.
6. Submit plugging report (CP-4) to K.C.C. after plugging is completed.
7. Obtain an approved injection docket number before disposing of salt water.
8. Notify K.C.C. within 10 days when injection commences or terminates.
9. If an alternate 2 completion, cement in the production pipe from below any usable water to surface within 120 days of spud date.

RECEIVED
STATE CORPORATION COMMISSION

02-12-1987
FEB 12 1987

A Regular Section of Land
1 Mile = 5,280 Ft.

CONSERVATION DIVISION
Wichita, Kansas

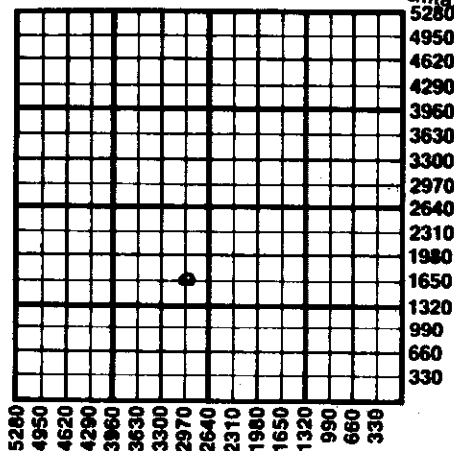

State Corporation Commission of Kansas
Conservation Division
200 Colorado Derby Building
Wichita, Kansas 67202
(316) 263-3238