

CARD MUST BE TYPED

State of Kansas
NOTICE OF INTENTION TO DRILL
(see rules on reverse side)

5

CARD MUST BE SIGNED

Starting Date: Dec. 10 1985
month day year

API Number 15- 165-21,329-00-00
 East

OPERATOR: License # 4668
Name Seville Drilling Corp.
Address P.O. Box 668
City/State/Zip La Crosse, Ks. 67548
Contact Person D. L. Stegman
Phone 913-222-2646

. SE. SW. NW ... Sec. 26. Twp. 16. S, Rge 17. ...
(location)
... 2970 ... Ft North from Southeast Corner of Section
... 4290 ... Ft West from Southeast Corner of Section
(Note: Locate well on Section Plat on reverse side)

CONTRACTOR: License # 5110
Name B & B Drilling, Inc.
City/State Wichita, Ks.

Nearest lease or unit boundary line ... 320 ... feet.
County Rush
Lease Name Urban Well# D.#1
Domestic well within 330 feet: yes no
Municipal well within one mile: yes no

Well Drilled For: Well Class: Type Equipment:
 Oil Swd Infield Mud Rotary
 Gas Inj Pool Ext. Air Rotary
 OWWO Expl Wildcat Cable

Depth to Bottom of fresh water ... 350 ... feet
Lowest usable water formation ... Dakota
Depth to Bottom of usable water ... 750 ... feet
Surface pipe by Alternate: 1 2
Surface pipe to be set ... 1150 ... feet
Conductor pipe if any required ... none ... feet
Ground surface elevation ... 2040 ... feet MSL
This Authorization Expires 4-28-86
Approved By 10-28-85

If OWWO: old well info as follows:

Operator
Well Name
Comp Date Old Total Depth
Projected Total Depth 3695 feet
Projected Formation at TD Granite
Expected Producing Formations Lansing

I certify that we will comply with K.S.A. 55-101, et seq., plus eventually plugging hole to K.C.C. specifications.

Date 10/25/85 Signature of Operator or Agent *D.L. Stegman* Title Expl. & Prod. Manager...
REH/KOATE

Must be filed with the K.C.C. five (5) days prior to commencing well
This card void if drilling not started within six (6) months of date received by K.C.C.


RECEIVED
STATE CORPORATION COMMISSION
10-28-1985
OCT 28 1985

Important procedures to follow:

A Regular Section of Land
1 Mile = 5,280 Ft.

CONSERVATION DIVISION
Wichita, Kansas

1. Notify District office before setting surface casing.
2. Set surface casing by circulating cement to the top.
3. File completion forms ACO-1 with K.C.C. within 90 days of well completion, following instructions on ACO-1, side 1, and including copies of wireline logs.
4. Notify District office 48 hours prior to old well workover or re-entry.
5. Prior to plugging, prepare a plugging plan, then obtain agreement from the appropriate district office for an approved plugging plan.
6. Submit plugging report (CP-4) to K.C.C. after plugging is completed.
7. Obtain an approved injection docket number before disposing of salt water.
8. Notify K.C.C. within 10 days when injection commences or terminates.
9. If an alternate 2 completion, cement in the production pipe from below any usable water to surface within 120 days of spud date.

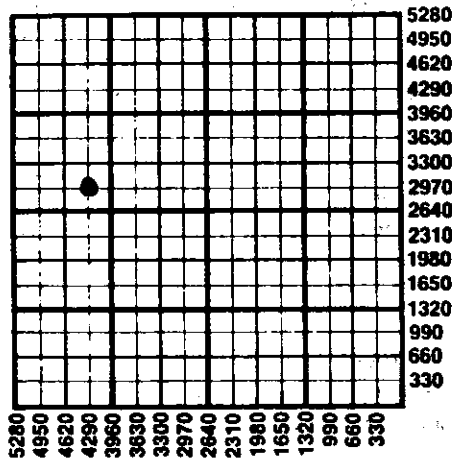

State Corporation Commission of Kansas
Conservation Division
200 Colorado Derby Building
Wichita, Kansas 67202
(316) 263-3238



JOHN CARLIN
MICHAEL LENNEN
MARGALEE WRIGHT
KEITH R. HENLEY
JUDITH A. MCCONNELL
BRIAN J. MOLINE

Governor
Chairman
Commissioner
Commissioner
Executive Secretary
General Counsel

State Corporation Commission

CONSERVATION DIVISION

(Oil, Gas and Water)
200 Colorado Derby Building
202 West 1st Street
WICHITA, KANSAS 67202-1286

November 5, 1986

Seville Drilling Corp.
P.O. Box 668
La Crosse, KS 67548

Re: Urban #D-1, 26-16-17W, Rush County, KS

Gentlemen:

In reviewing our Intent-to-Drill File we find the approved notice of Intent-To-Drill for the above-referenced well or lease has expired per K.A.R. 82-3-103(d). The current status of this well or lease is unknown. According to K.A.R. 82-3-130, a completion report (ACO-1) must be filed within 120 days after spud date, regardless of how it is completed.

Please furnish us the following information and return it along with the required forms within fifteen (15) days of this mailing.

- Well was never drilled.
(Complete affidavit below and return to this office.)
- Well has been abandoned.
(Return with completed ACO-1 & CP-4 Plugging Form.)
- Well is Temporarily Abandoned.
(Return with completed ACO-1 & CP1-11 Temporarily Abandoned Well Form.)
- Well was completed and producing.
(Return with completed ACO-1 & Contact field office for state test.)

Should you have any questions please call (316) 263-3238.

Respectfully,
Kathy Carlisle
Kathy Carlisle

AFFIDAVIT

I, Daniel L. Stegman, am the duly authorized agent or representative for Seville Drilling Corp.. I hereby state that the Urban #D-1 well or lease Sec. 26, Twn. 16S, Rng. 17W in Rush County for which the Intent-to-Drill was issued to the above named entity by the Kansas Corporation Commission was never drilled.

Daniel L. Stegman
NAME & TITLE Exp. & Prod. Manager

Subscribed and sworn to before me this 14th day of November, 19 86.

Anita R. Stegman
Notary Public Anita R. Stegman



My Commission expires: Feb. 23, 1988