

CARD MUST BE TYPED

State of Kansas

CARD MUST BE SIGNED

# NOTICE OF INTENTION TO DRILL

(see rules on reverse side)



Expected Spud Date..... September 28, 1988.....  
month day year

API Number 15-10-21,488-0000

Appx. \_\_\_\_\_ East  
C E/2 NW/4 Sec. 34 Twp. 16 S, Rg 27 \_\_\_\_\_ X West

OPERATOR: License # 9069.....

Name General Oil Company, Inc.

Address 1540 N. Broadway, Ste. 202

City/State/Zip Wichita, Ks 67214

Contact Person John Bannister

Phone (316)-263-8588

2300 3960 Ft. from South Line of Section  
2000 3300 Ft. from East Line of Section

(Note: Locate well on Section Plat on reverse side)

CONTRACTOR: License # 9421.....

Name Boger Brothers Drilling, Inc.

City/State Great Bend, Ks 67530

Nearest lease or unit boundary line 660 feet

County Lane

Lease Name Paramount Peak Well # 1-34

Ground surface elevation 2684 feet MSL

Domestic well within 330 feet: \_\_\_\_\_ yes X no

Municipal well within one mile: \_\_\_\_\_ yes X no

Well Drilled For: Well Class: Type Equipment:

X Oil \_\_\_\_\_ Storage \_\_\_\_\_ Infield X Mud Rotary

\_\_\_\_\_ Gas \_\_\_\_\_ Inj X Pool Ext. \_\_\_\_\_ Air Rotary

\_\_\_\_\_ OWWO \_\_\_\_\_ Expl \_\_\_\_\_ Wildcat \_\_\_\_\_ Cable

Depth to bottom of fresh water 180'

Depth to bottom of usable water 1100'

Surface pipe by Alternate: 1 \_\_\_\_\_ 2 X

Surface pipe planned to be set 200'

If OWWO: old well info as follows:

Conductor pipe required \_\_\_\_\_

Operator \_\_\_\_\_

Projected Total Depth 4630 feet

Well Name \_\_\_\_\_

Formation Mississippian

Comp Date \_\_\_\_\_ Old Total Depth \_\_\_\_\_

I certify that well will comply with K.S.A. 55-101, et seq., plus eventually plugging and to KCC specifications.

Date 9-20-88 Signature of Operator or Agent \_\_\_\_\_

Title President

For KCC Use:

Conductor Pipe Required \_\_\_\_\_ feet; Minimum Surface Pipe Required 200' feet per Alt. X (2)

This Authorization Expires 3-20-89 Approved By LKM 9-20-88


EFFECTIVE DATE: 9-25-88

Must be filed with the K.C.C. five (5) days prior to commencing well  
This card void if drilling not started within six (6) months of date received by K.C.C.

### Important procedures to follow:

1. Notify District office before setting surface casing.
2. Set surface casing by circulating cement to the top.
3. File completion forms ACO-1 with K.C.C. within 120 days of well spud date, following instructions on ACO-1, side 1, and including copies of wireline logs.
4. Notify District office 48 hours prior to old well workover or re-entry.
5. Prior to filing Intent, prepare a proposed plugging plan in case well is D & A, then obtain approval of plan when calling district office prior to setting surface pipe.
6. Submit plugging report (CP-4) to K.C.C. after plugging is completed.
7. Obtain an approved injection docket number before disposing of salt water.
8. Notify K.C.C. within 10 days when injection commences or terminates.
9. If an alternate 2 completion, cement in the production pipe from below any usable water to surface within 120 days of spud date.

### A Regular Section of Land 1 Mile = 5,280 Ft.

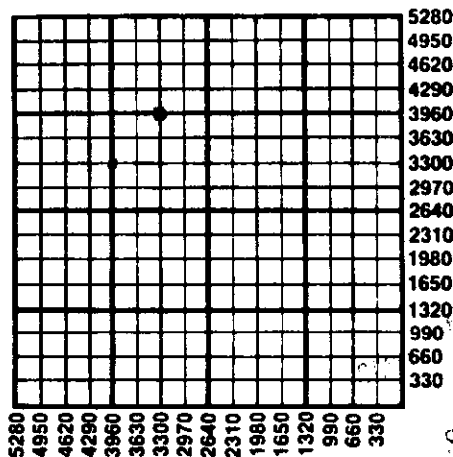

SEP 20 1988  
9-20-88  
Conservation Division  
Wichita, Kansas

State Corporation Commission of Kansas  
Conservation Division  
200 Colorado Derby Building  
Wichita, Kansas 67202-1212  
(316) 263-3238