


STATE OF KANSAS
STATE CORPORATION COMMISSION

WELL PLUGGING RECORD

Give All Information Completely
Make Required Affidavit
Mail or Deliver Report to
Conservation Division
State Corporation Comm.
245 North Water
Wichita, KS 67202

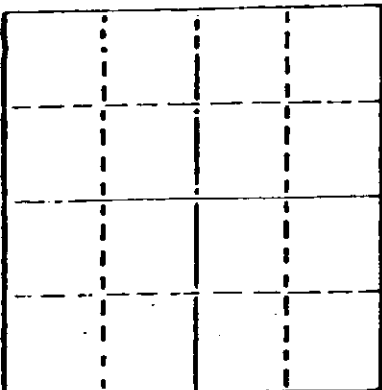

NESS County. Sec. 23 Twp. 20S Rge. 26W E/W
Location as "NE/CNW $\frac{1}{4}$ SW $\frac{1}{4}$ " or footage from lines
SW NW Ness

Lease Owner PICKRELL DRILLING COMPANY
Lease Name GOODMAN "H" Well No. 1
Office Address 205 LITWIN BLDG., WICHITA, KS. 67202
Character of Well (Completed as Oil, Gas or Dry Hole) DRY HOLE

Date Well completed 3-31-78 19
Application for plugging filed 3-31-78 19
Application for plugging approved 3-31-78 19
Plugging commenced 3-31-78 19
Plugging completed 3-31-78 19
Reason for abandonment of well or producing formation DRY HOLE

If a producing well is abandoned, date of last production 19

Was permission obtained from the Conservation Division or its agents before plugging was commenced? Yes

Name of Conservation Agent who supervised plugging of this well Leo Massey
Producing formation Depth to top Bottom Total Depth of Well 4550
Show depth and thickness of all water, oil and gas formations.

OIL, GAS OR WATER RECORDS

CASING RECORD

FORMATION	CONTENT	FROM	TO	SIZE	PUT IN	PULLED OUT
				8 5/8	216	None

Describe in detail the manner in which the well was plugged, indicating where the mud fluid was placed and the method or methods used in introducing it into the hold. If cement or other plugs were used, state the character of same and depth placed, from feet to feet for each plug set.

600' with 70 sacks
215' with 20 sacks
40' Bridge with 10 sacks
Comp. 6:45PM 3-31-78

04-05-1978

(If additional description is necessary, use BACK of this sheet)

Name of Plugging Contractor PICKRELL DRILLING COMPANY

STATE OF KANSAS COUNTY OF SEDGWICK, ss.
C. W. SEBITS (employee of owner) or (owner or operator)
of the above-described well, being first duly sworn on oath, says: That I have knowledge of the facts, statements, and matters herein contained and the log of the above-described well as filed and that the same are true and correct. So help me God. BY: C. W. SEBITS

(Signature) [Signature] 205 LITWIN BLDG., WICHITA, KS. 67202
(Address)

SUBSCRIBED AND SWORN TO before me this 4 day of April, 1978

My commission expires 2-18-80

[Signature] Notary Public.
Jo Ann Sarver



ROTARY DRILLING LOG

COMPANY: PICKRELL DRILLING COMPANY
 205 LITWIN BLDG.
 WICHITA, KS. 67202
 LOCATION: GOODMAN "H" #1
 SW NW Sec. 23-20S-26W
 NESS COUNTY, KANSAS
 CONTRACTOR: PICKRELL DRILLING COMPANY
 Wichita, Kansas

Rotary Drilling Commenced 3-23-78
 Rotary Drilling Completed 3-31-78

CASING RECORD: Surf. casing 8 5/8" set at 216' with 140 sx. Comp. 3-23-78 @ 8:00PM

LOG

(Figures indicate bottom of formation — measurements from top of rotary bushing.)

Top Soil	222
Shale	345
Shale	428
Shale	555
Shale & Red Beds	1220
Sand	1460
Shale	1725
Shale	1740
Shale	2070
Shale & Lime	2335
Shale & Lime	2535
Lime	2725
Lime & Shale	2895
Shale & Lime	3075
Lime & Shale	3225
Lime & Shale	3390
Shale & Lime	3535
Lime & Shale	3700
Shale & Lime	3880
Lime	4025
Lime	4170
Lime & Shale	4290
Lime	4375
Lime	4455
Lime & Sand	4472
Lime	4487
Lime	4550

04-05-1978

The undersigned, C. W. SEBITS, Attorney-in-Fact for PICKRELL DRILLING COMPANY, hereby certifies in behalf of said Company, that the above is a true and correct log of the formation encountered in drilling the above well as reflected by the Daily Drilling Reports.

PICKRELL DRILLING COMPANY

By C. W. SEBITS

Attorney-in-Fact

C. W. SEBITS

STATE OF KANSAS

COUNTY OF SEDGWICK } ss.:

On this 4 day of April, 19 78, before me the undersigned, a Notary Public, in and for

the County and State aforesaid, personally appeared C. W. SEBITS, to me known to be the identical person who subscribed the name of PICKRELL DRILLING COMPANY to the foregoing instrument as its Attorney-in-Fact and acknowledged to me that he executed the same as his free and voluntary act and deed, and as the free and voluntary act and deed of such company, for the uses and purposes therein set forth.

Given under my hand and seal of office the day and year last above written.

My commission expires: 2-18-80



Jo Ann Sarver
 Notary Public

Jo Ann Sarver