


STATE OF KANSAS
STATE CORPORATION COMMISSION

Give All Information Completely
Make Required Affidavit
Mail or Deliver Report to:
Conservation Division
State Corporation Commission
211 No. Broadway
Wichita, Kansas

15-135-00153-00-00
WELL PLUGGING RECORD

NORTH

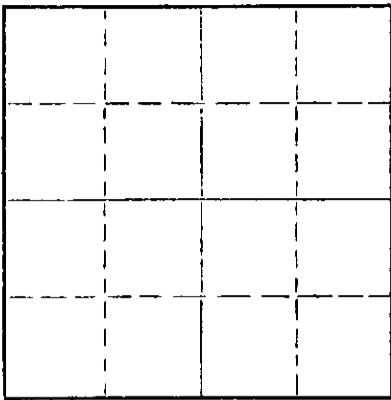

Locate well correctly on above
Section Plat

Ness County, Sec. 1 Twp. 20S Rge. 26 (E) (W)
Location as "NE/CNW/SE/SW" or footage from lines. NE NE SW
Lease Owner National Cooperative Refinery Association
Lease Name Beetz Well No. 1
Office Address 305 Rule Building, Wichita, Kansas
Character of Well (completed as Oil, Gas or Dry Hole) Dry Hole
Date well completed March 20, 1957
Application for plugging filed March 20, 1957
Application for plugging approved March 21, 1957
Plugging commenced March 20, 1957
Plugging completed March 20, 1957
Reason for abandonment of well or producing formation Dry Hole

If a producing well is abandoned, date of last production 19
Was permission obtained from the Conservation Division or its agents before plugging was commenced? Yes

Name of Conservation Agent who supervised plugging of this well R. M. Brundage.
Producing formation _____ Depth to top _____ Bottom _____ Total Depth of Well 4690 Feet
Show depth and thickness of all water, oil and gas formations.

OIL, GAS OR WATER RECORDS

CASING RECORD

FORMATION	CONTENT	FROM	TO	SIZE	PUT IN	PULLED OUT
				8 5/8"	772'	None

Describe in detail the manner in which the well was plugged, indicating where the mud fluid was placed and the method or methods used in introducing it into the hole. If cement or other plugs were used, state the character of same and depth placed, from _____ feet to _____ feet for each plug set.

Filled hole with heavy mud to 700'. Set bottom plug with 1/3 sack hulls and 20 sacks of cement. Filled hole to 35' with mud. Top plug set with 1/3 sack hulls, 10 sacks of cement. Filled to base of cellar.

RECEIVED
STATE CORPORATION COMMISSION
MAR 21 1957
CONSERVATION DIVISION
WICHITA, KANSAS
03-27-1957

(If additional description is necessary, use BACK of this sheet)
Name of Plugging Contractor Lewis Drilling Company
Address 915 Union Center, Wichita, Kansas

STATE OF Kansas, COUNTY OF Sedgwick, ss.
C. R. Sears (employee of owner) or (~~owner or operator~~) of the above-described well, being first duly sworn on oath, says: That I have knowledge of the facts, statements, and matters herein contained and the log of the above-described well as filed and that the same are true and correct. So help me God.

(Signature) C. R. Sears (C. R. Sears)
305 Rule Building, Wichita, Kansas
(Address)

SUBSCRIBED AND SWORN TO before me this 26th day of March 19 57
Nell McComb
Nell McComb Notary Public.

My commission expires November 26, 1960.

PLUGGING
FILE SEC 1 T 20 R 26W
BOOK PAGE 149 LINE 44

WELL LOG

15-135-00153-00-00

COMPANY National Cooperative Refinery Association

SEC. 1 T. 20-S R. 26-W

FARM Beets

NO. 1

LOC. NE 1/4 NE 1/4 SW 1/4

TOTAL DEPTH 4690'

COMM. 3-3-57


COMP. 3-20-57

SHOT OR TREATED

CONTRACTOR Lewis Drilling Company

ISSUED

COUNTY Ness KANSAS

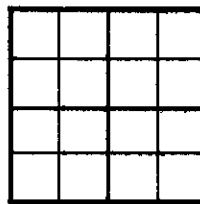

ELEVATION 2544' K.O.B.

PRODUCTION

CASING

20	10
15	8-5/8" = 778'
12	6
13	5

FIGURES INDICATE BOTTOM OF FORMATIONS

0 = 60	Clay & Shale
60 = 390	Shale
390 = 440	Sand & Shale
440 = 570	Shale
570 = 690	Sand
690 = 935	Shale
935 = 1180	Red Beds
1180 = 1215	Anhydrite
1215 = 1600	Shale
1600 = 3950	Shale & Lime
3950 = 4510	Lime
4510 = 4532	Lime & Sand
4532 = 4543	Lime
4543 = 4580	Conglomerate
4580 = 4690	Lime
4690 = T.D.	

GEOLOGIC TOPS:

Heebner	3890
Lansing	3933
Conglomerate	4518
Mississippian	4533

PLUGGING
 FILE SEC 1 T. 20 R. 26W
 BOOK PAGE 149 LINE 44

03-27-1957

State of KANSAS }
County of SEDGWICK } ss:

I, J. Fred Hambricht of the Lewis Drilling Company

upon oath state that the above and foregoing is a true and correct copy of the log of the Beets #1 well.

Subscribed and sworn to before me this 25th day of March 1957

My Commission Expires: August 20, 1960

J. Fred Hambricht

A. R. Derrington

NOTARY PUBLIC

(A. R. Derrington)