


WELL PLUGGING RECORD

Give All Information Completely
Make Required Affidavit
Mail or Deliver Report to:
Conservation Division
State Corporation Commission
211 No. Broadway
Wichita, Kansas

Barber County. Sec. 31 Twp. 31S Rge. 11 1E1 W (W)
Location as "NE/CNW&SW&" or footage from lines C SE NE
Lease Owner Aylward Drilling Company
Lease Name Swartz "D" Well No. 2
Office Address 813 First Nat'l Bldg., Wichita, Kansas
Character of Well (completed as Oil, Gas or Dry Hole) Gas well
Date well completed 12-18 19 46
Application for plugging filed 19
Application for plugging approved 19
Plugging commenced 1-29 19 64
Plugging completed 2-04 19 64
Reason for abandonment of well or producing formation depleted

NORTH

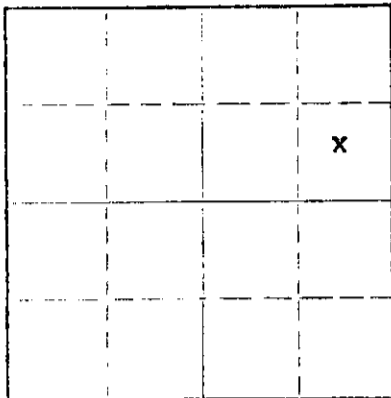

Locate well correctly on above
Section Plat

If a producing well is abandoned, date of last production 19
Was permission obtained from the Conservation Division or its agents before plugging was commenced? yes

Name of Conservation Agent who supervised plugging of this well Archie Elving
Producing formation Depth to top Bottom Total Depth of Well 3623 Feet
Show depth and thickness of all water, oil and gas formations.

OIL, GAS OR WATER RECORDS

CASING RECORD

FORMATION	CONTENT	FROM	TO	SIZE	PUT IN	PULLED OUT
				9 5/8	174	circulated
				7"	3493	2565.

Describe in detail the manner in which the well was plugged, indicating where the mud fluid was placed and the method or methods used in introducing it into the hole. If cement or other plugs were used, state the character of same and depth placed, from feet to feet for each plug set.

Filled hole with chat to 3300 feet and dumped 5 sacks cement.
Set 15 foot rock bridge at 240 feet and dumped 50 sacks cement.
Cement fill up to 160 feet, mud hole to 40 feet, set 10 foot
rock bridge and dumped 12 sacks cement.

RECEIVED
STATE CORPORATION COMMISSION

FEB 19 1964

2-12-64

CONSERVATION DIVISION
WICHITA, KANSAS

(If additional description is necessary, use BACK of this sheet)

Name of Plugging Contractor Flint Engineering & Construction Co.
Address Box 342, El Dorado, Kansas

STATE OF Kansas, COUNTY OF Butler, ss.

 (employee of owner) or (owner or operator) of the above-described well, being first duly sworn on oath, says: That I have knowledge of the facts, statements, and matters herein contained and the log of the above-described well as filed and that the same are true and correct. So help me God.

(Signature) Mary Payne
El Dorado, Kansas
(Address)

SUBSCRIBED AND SWORN TO before me this 11th day of February, 19 64

Ronald R. Hanson
Notary Public.

My commission expires September 27, 1967