

STATE OF KANSAS
STATE CORPORATION COMMISSION

WELL PLUGGING RECORD

Give All Information Completely
Make Required Affidavit
Mail or Deliver Report to:
Conservation Division
State Corporation Commission
212 North Market, Insurance Bldg.
Wichita, Kansas

Barber County. Sec. 31 Twp. 31 Rge. 11 (E) W (W)

Location as "NE/CNW/SW" or footage from lines NW SW

Lease Owner Aylward Drilling Co.

Lease Name Regnier #1 Well No.

Office Address Wichita, Kansas

Character of Well (completed as Oil, Gas or Dry Hole) Gas

Date well completed 8/24/46 19

Application for plugging filed 3/14/60 19

Application for plugging approved 3/15/60 19


Plugging commenced 3-25-60 19

Plugging completed 3-29-60 19

Reason for abandonment of well or producing formation depleted

If a producing well is abandoned, date of last production 19

Was permission obtained from the Conservation Division or its agents before plugging was commenced? yes

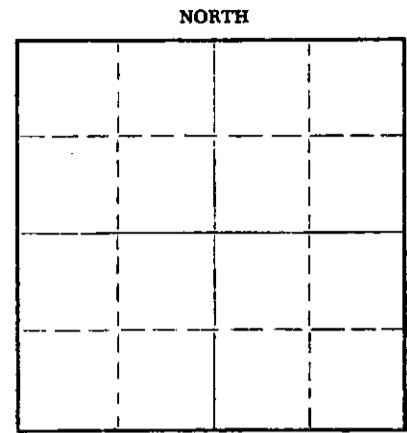

Name of Conservation Agent who supervised plugging of this well Fred Hampel

Producing formation Elgin Depth to top 3312 Bottom 3316 Total Depth of Well 3316 Feet

Show depth and thickness of all water, oil and gas formations.

OIL, GAS OR WATER RECORDS

CASING RECORD

FORMATION	CONTENT	FROM	TO	SIZE	PUT IN	PULLED OUT
				8-5/8"	159'	none
				5-1/2"	3316'	2453'

Describe in detail the manner in which the well was plugged, indicating where the mud fluid was placed and the method or methods used in introducing it into the hole. If cement or other plugs were used, state the character of same and depth placed, from _____ feet to _____ feet for each plug set.

Checked the hole to 3316' and found it open.
Filled w/sand to 3290' and dumped 4 sacks of cement with bailer. Pulled 5' casing.
Cleared hole and set rock bridge from 300' to 290' and dumped 8 sacks of cement with bailer, left set overnight. Bailed hole dry to cement plug and dumped 7 more sacks of cement. Mudded the hole to 150', set rock bridge to 140' and dumped 10 sacks of cement. Mudded the hole to 35', set rock bridge to 30' and ran 10 sacks of cement to base of cellar.

APR 21 1960
4-21-60
CONSERVATION DIVISION
Wichita, Kansas

PLUGGING COMPLETED

(If additional description is necessary, use BACK of this sheet)

Name of Plugging Contractor Knight Casing Pulling Co.

Address Chase, Kansas

STATE OF KANSAS, COUNTY OF RICE, ss.

I, Noel J. Knight (employee of owner) or (owner or operator) of the above-described well, being first duly sworn on oath, says: That I have knowledge of the facts, statements, and matters herein contained and the log of the above-described well as filed and that the same are true and correct. So help me God.

(Signature) Noel Knight
Chase, Kansas
(Address)

SUBSCRIBED AND SWORN TO before me this 1st day of April, 1960

My commission expires 9-27-62

Thomas V. Dyer
Notary Public.



R
REGNIER #1

Casing Record: Company: Olson Drilling Co. & Globe Oil & Refining Co. Location: 100' W of C NE SW
 8 5/8" - 159' Contractor: Olson Drilling Company Sec. 31-31-11W
 5 1/2" - 3316' Commenced: August 7, 1946 Barber County, Kansas
 Completed: August 24, 1946 Elevation: 1502'

	<u>From</u>	<u>To</u>	<u>Remarks</u>
Sand & Gravel	0	63	Set 8 5/8" surface Pipe at 159' w/150 sacks cement.
Red Shale & Shells	63	183	
Sand, Shale & Shells	183	410	
Sand & Shells	410	675	Geological Tops:
Shale & Shells	675	1140	
Shale, Sand & Shells	1140	1358	Elgin Sand 3312
Salt	1358	1485	
Shale & Shells	1485	1574	
Shale & Lime	1574	2078	
Lime	2078	2130	
Lime & Shale	2130	2330	
Shale & Shells	2330	2440	DST 3318-35 Open 10 min. Gas in 5"
Shale	2440	2575	Rec. 30' mud.
Shale & Shells	2575	2772	BHP 1320# - FP 735#.
Lime & Shale	2772	2930	
Shale	2930	3000	
Lime	3000	3035	
Shale & Lime	3035	3144	
Shale	3144	3227	
Shale & Lime	3227	3315	Set 5 1/2" casing @ 3316' w/150 sacks cement.
Sand	3315	3335 T.D.	

RECORDED
 APR 21 1960
 4-21-60
 DIVISION

I hereby certify that this is a true and correct copy of the above log to the best of my knowledge.

Charles D. Williams

Subscribed and sworn to before me this 20th day of April, 1960

Diane Jessup
 Notary Public

My commission expires December 11, 1961