


Give All Information Completely
Make Required Affidavit
Mail or Deliver Report to:
Conservation Division
State Corporation Commission
211 No. Broadway
Wichita, Kansas

Rush County, Sec. 5 Twp. 16S Rge. (E) 17W (W)

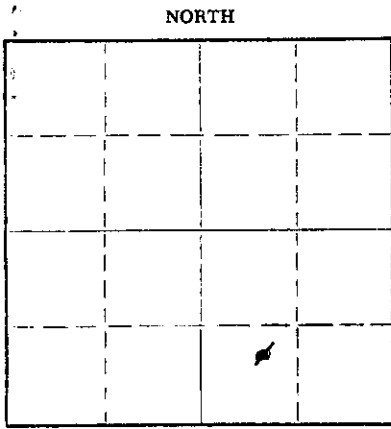

Locate well correctly on above Section Plat

Location as "NE/CNW/SW" or footage from lines NE SW SE
Lease Owner Lario Oil & Gas Company
Lease Name Basgall Well No. 1
Office Address 301 S. Market, Wichita 2, Kansas
Character of Well (completed as Oil, Gas or Dry Hole) Oil
Date well completed October 26 19 60
Application for plugging filed October 4 19 62
Application for plugging approved October 5 19 62
Plugging commenced October 2 19 62
Plugging completed October 5 19 62
Reason for abandonment of well or producing formation Depleted

If a producing well is abandoned, date of last production October 1 19 62
Was permission obtained from the Conservation Division or its agents before plugging was commenced? Yes

Name of Conservation Agent who supervised plugging of this well Eldon Petty (Permit No. 396)
Producing formation Arbuckle Depth to top 3520 Bottom _____ Total Depth of Well 3600 Feet
Show depth and thickness of all water, oil and gas formations.

OIL, GAS OR WATER RECORDS

CASING RECORD

FORMATION	CONTENT	FROM	TO	SIZE	PUT IN	PULLED OUT
				8 5/8"	1135	None
				5 1/2"	3630	2909

Describe in detail the manner in which the well was plugged, indicating where the mud fluid was placed and the method or methods used in introducing it into the hole. If cement or other plugs were used, state the character of same and depth placed, from _____ feet to _____ feet for each plug set.

Filled with sand from 3600' to 3540'. Run 4 sacks of cement from 3540' to 3520'. Pumped 24 sacks of jell mud and 20 sacks of cement at 480'. Pumped 20 sacks of cement at 180'. Bailed mud to 30' and run 10 sacks of cement to base of cellar.

RECEIVED
STATE CORPORATION COMMISSION

1077 1562

CONSERVATION DIVISION
Wichita, Kansas

11-07-1962

(If additional description is necessary, use BACK of this sheet)

Name of Plugging Contractor Glenn & Smith Pipe Pulling Co.
Address Box 114, Ellinwood, Kansas

STATE OF KANSAS, COUNTY OF SEDGWICK, ss.
Leo Ross (employee of owner) or ~~(Notary Public)~~

well, being first duly sworn on oath, says: That I have knowledge of the facts, statements, and matters herein contained and the log of the above-described well as filed and that the same are true and correct. So help me God.

(Signature) Leo Ross

301 S. Market St., Wichita 2, Kansas
(Address)

SUBSCRIBED AND SWORN TO before me this 6th day of November, 19 62

Frances Leslie
Notary Public.

My commission expires July 21, 1966

LARIO OIL & GAS COMPANY
 Basgall No. 1
 NE SW SE Sec. 5-16S-17W
 Rush County, Kansas

RECEIVED
 STATE CORPORATION COMMISSION

OCT 5 1960

CONSERVATION DIVISION
 Wichita, Kansas

10-05-1962

Drilling Commenced: September 21, 1960
 Drilling Completed: October 4, 1960
 Well Completed: October 26, 1960
 Drilling Contractor: Red Tiger Drilling Company
 Total Depth: 3758' P.B. 3600'
 I.P. - 5 bbls. oil plus 10 bbls. water

CASING RECORD:

8 5/8" 1135' Cem. w/ 500 sacks
 common, 2% gel
 5 1/2" 3630' Set @ 3628' Cem. w/
 100 sacks posmix

<u>Formation</u>	<u>Depth</u>
Shale & shells	340
Shale	540
Sand	750
Shale	875
Shale & red bed	1120
Anhydrite	1160
Shale & shells	2045
Shale & lime	3020
Lime	3590
Lime sandy	3650
Lime	3758

GEOLOGICAL TOPS - R.B. Meas.

Anhydrite	1120 (-871)
Topeka	2926 (-935)
Heebner	3215 (-1224)
Toronto	3235 (-1244)
Lansing-Kansas City	3268 (-1277)
Base Kansas City	3494 (-1503)
Arbuckle	3520 (-1529)
Reagan Sand	3675 (-1684)
Granite Wash	3690 (-1699)
Solid Granite	3754 (-1763)
Total Depth	3758 (-1767)

10-8-60 Welex perf. 16/3548-3552 (sq.)
 10-8-60 Acidized w/ 250 gallons 15% Non-E.
 10-12-60 Welex perf. 12/3546-3548 (sq.)
 10-12-60 Acidized w/ 250 gallons Non-E.
 10-18-60 Welex perf. 16/3550-3554
 10-18-60 Acidized w/ 100 gallons Non-E.
 10-19-60 Acidized w/ 250 gallons Non-E.

1-14-61 Halliburton acidized w/ 3000 gallons
 HV acid.