

STATE OF KANSAS
STATE CORPORATION COMMISSION


15-1105-01839-00-00

WELL PLUGGING RECORD

Give All Information Completely
Make Required Affidavit
Mail or Deliver Report to:
Conservation Division
State Corporation Commission
800 Bittling Building
Wichita, Kansas

Rush County, Sec. 5 Twp. 16S Rge. (E) 17W(W)

Location as "NE/CNW/SW" or footage from lines SW SE NE
Lease Owner Lario Oil & Gas Company
Lease Name Jacobs "B" Well No. 1
Office Address 301 S. Market, Wichita 2, Kansas
Character of Well (completed as Oil, Gas or Dry Hole) Dry Hole
Date well completed November 8, 1961
Application for plugging filed (Verbal 11-8-61) November 15, 1961
Application for plugging approved November 8, 1961
Plugging commenced November 8, 1961
Plugging completed November 8, 1961
Reason for abandonment of well or producing formation Dry Hole

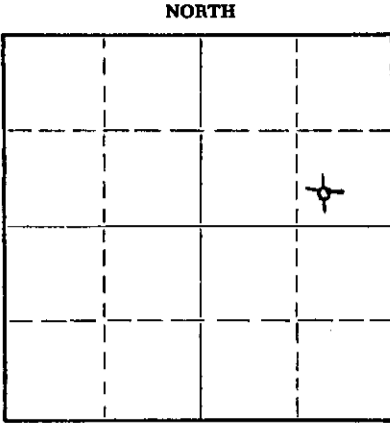

Locate well correctly on above Section Plat

If a producing well is abandoned, date of last production 19
Was permission obtained from the Conservation Division or its agents before plugging was commenced? Yes

Name of Conservation Agent who supervised plugging of this well Eldon Petty
Producing formation _____ Depth to top _____ Bottom _____ Total Depth of Well 3530 Feet
Show depth and thickness of all water, oil and gas formations.

OIL, GAS OR WATER RECORDS

CASING RECORD

FORMATION	CONTENT	FROM	TO	SIZE	PUT IN	PULLED OUT
				8 5/8"	1082 Set	1078 w/ 575 sacks

Describe in detail the manner in which the well was plugged, indicating where the mud fluid was placed and the method or methods used in introducing it into the hole. If cement or other plugs were used, state the character of same and depth placed, from _____ feet to _____ feet for each plug set.

Plug set at 450' with 20 sacks cement. No. 2 plug at 180' with 20 sacks cement.
No. 3 plug at 40' with 10 sacks cement.

RECEIVED
COMMISSION
CONSERVATION DIVISION
Wichita, Kansas
11-15-1961

(If additional description is necessary, use BACK of this sheet)
Name of Plugging Contractor Mast Drilling, Inc.
Address Russell, Kansas

STATE OF Kansas COUNTY OF Sedgwick, ss.
Leo Ross (employee of owner) or (owner or operator) of the above-described well, being first duly sworn on oath, says: That I have knowledge of the facts, statements, and matters herein contained and the log of the above-described well as filed and that the same are true and correct. So help me God.

(Signature) *Leo Ross*
301 S. Market, Wichita 2, Kansas (Address)

SUBSCRIBED AND SWORN TO before me this 15th day of November, 1961

My commission expires July 21, 1962 *Frances Leslie* Notary Public.

15-165-01839-00-00

LARIO OIL & GAS COMPANY
Jacobs "B" No. 1
SW SE NE Sec. 5-16S-17W
Rush County, Kansas

Drilling Commenced: October 28, 1961
Drilling Completed: November 8, 1961
Drilling Contractor: Mast Drilling, Inc.
Total Depth 3530'
I.P. - Dry & Abandoned

CASING RECORD:

8 5/8" 1082' (t.o.) Set @ 1078'
Cem. w/ 575 sacks

<u>Formation</u>	<u>Depth</u>
Clay	40
Shale	320
Sand	360
Hard sand & shale	485
Sand	705
Shale	855
Red bed	1065
Anhydrite	1105
Red bed	1275
Shale & shells	1740
Shale & lime	1965
Lime & shale	2250
Shale & shells	2385
Shale & lime	2715
Lime & shale	2965
Lime	3502
Conglomerate & Arbuckle	3514
Arbuckle	3530

GEOLOGICAL TOPS - K.B. MEAS.

Elevation	1928 K.B.
Topeka	2885 (-957)
Heebner	3170 (-1242)
Toronto	3188 (-1260)
Lansing	3218 (-1290)
Base Kansas City	3443 (-1515)
Conglomerate	3463 (-1535)
Errrosional Arbuckle?	3502 (-1574)
Arbuckle	3507 (-1579)
Total Depth	3530 (-1602)

RECEIVED
STATE CORPORATION COMMISSION

NOV 15 1961

CONSERVATION DIVISION
Wichita, Kansas

11-15-1961