


WELL PLUGGING RECORD

Give All Information Completely
Make Required Affidavit
Mail or Deliver Report to:
Conservation Division
State Corporation Commission
212 No. Market
Wichita, Kansas

Rush County, Sec. 5 Twp. 16S Rge. 17 (E) (W) X

NORTH

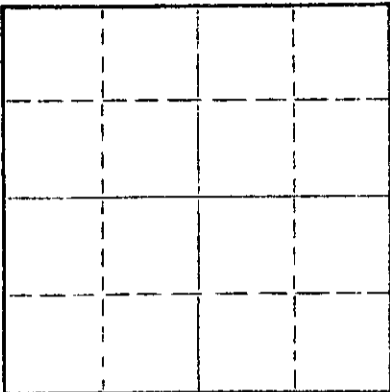

Locate well correctly on above Section Plat

Location as "NE/CNW/SW" or footage from lines N¹/₂ SW
Lease Owner Frontier Oil Company
Lease Name Kisner Well No. 1
Office Address 310 South Main Russell, Kansas
Character of Well (completed as Oil, Gas or Dry Hole) _____
Date well completed _____ 19____
Application for plugging filed _____ 19____
Application for plugging approved _____ 19____
Plugging commenced 8-8-69 _____ 19____
Plugging completed 8-12-69 _____ 19____
Reason for abandonment of well or producing formation _____

If a producing well is abandoned, date of last production _____ 19____
Was permission obtained from the Conservation Division or its agents before plugging was commenced? Yes

Name of Conservation Agent who supervised plugging of this well Leo F. Massey
Producing formation _____ Depth to top _____ Bottom _____ Total Depth of Well 3247 Feet
Show depth and thickness of all water, oil and gas formations.

OIL, GAS OR WATER RECORDS

CASING RECORD

| FORMATION | CONTENT | FROM | TO | SIZE | PUT IN | PULLED OUT |
|-----------|---------|------|----|-------|--------|------------|
| | | | | 8 5/8 | 1082 | None |
| | | | | 4 1/2 | None | 2229 |
| | | | | | | |
| | | | | | | |
| | | | | | | |
| | | | | | | |

RECEIVED
STATE CORPORATION COMMISSION
AUG 14 1969
CONSERVATION DIVISION
Wichita, Kansas

Describe in detail the manner in which the well was plugged, indicating where the mud fluid was placed and the method or methods used in introducing it into the hole. If cement or other plugs were used, state the character of same and depth placed, from _____ feet to _____ feet for each plug set.

08-14-1969

Moved in. Rigged up pole. Sanded bottom back to 3100'. Digging cellar.

Dumped 4 sacks of cement on bottom with dump bailer. Finished digging cellar. Working pipe - 21" stretch at 75,000#.

Loaded hole with water. Shot pipe at 2490'. Shot #2 wouldn't go below 2330'. Shot pipe at 2300'. Working pipe. Pulling pipe.

Set plug in surface pipe at 450'. Build 30' rock bridge and dumped 5 sacks of cement.

Plugged hole with 6 yards of ready mix cement.

(If additional description is necessary, use BACK of this sheet)

Name of Plugging Contractor Forbes Casing Pulling Company, Inc.
Address P. O. Box 221 Great Bend, Kansas

STATE OF Kansas COUNTY OF Barton, ss.
James W. Rockhold

(employee of owner) or (owner or operator) of the above-described well, being first duly sworn on oath, says: That I have knowledge of the facts, statements, and matters herein contained and the log of the above-described well as filed and that the same are true and correct. So help me God.

(Signature) James W. Rockhold
P. O. Box 221 Great Bend, Kansas
(Address)

SUBSCRIBED AND SWORN TO before me this 13 day of August, 1969

My commission expires May 27, 1973

[Signature] Notary Public.