


WELL PLUGGING RECORD

Give All Information Completely
Make Required Affidavit
Mail or Deliver Report to:
Conservation Division
State Corporation Commission
211 No. Broadway
Wichita, Kansas

NORTH

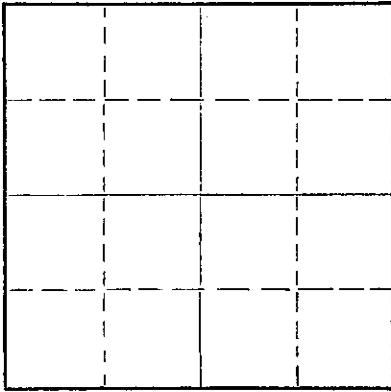

Locate well correctly on above
Section Plat

Rush County. Sec. 11 Twp. 16 Rge. 17 (E) W (W)
Location as "NE/CNW/SW" or footage from lines SW SE NW
Lease Owner Bennett & Roberts Drilling Co.
Lease Name Stegman "B" Well No. 1
Office Address Drawer 633, Russell, Ks.
Character of Well (completed as Oil, Gas or Dry Hole) Dry Hole
Date well completed 1/17 19 58
Application for plugging filed 1/17 verbally 19 58
Application for plugging approved 1/17 verbally 19 58
Plugging commenced 1/17 19 58
Plugging completed 1/17 19 58
Reason for abandonment of well or producing formation Dry Hole

If a producing well is abandoned, date of last production _____ 19____
Was permission obtained from the Conservation Division or its agents before plugging was commenced? Yes

Name of Conservation Agent who supervised plugging of this well Eldon Petty
Producing formation _____ Depth to top _____ Bottom _____ Total Depth of Well 3619 Feet
Show depth and thickness of all water, oil and gas formations.

OIL, GAS OR WATER RECORDS

CASING RECORD

FORMATION	CONTENT	FROM	TO	SIZE	PUT IN	PULLED OUT
				8 5/8"	1109'	None

Describe in detail the manner in which the well was plugged, indicating where the mud fluid was placed and the method or methods used in introducing it into the hole. If cement or other plugs were used, state the character of same and depth placed, from _____ feet to _____ feet for each plug set.

Plug @ 450' with 20 sacks cement. Plug @ 200' with 20 sacks cement. Plug @ 30' with 10 sacks cement. Job completed @ 7 P.M. Cement mixed by Sun Oilwell Cementing Company and pumped through drill pipe.

RECEIVED
STATE CORPORATION COMMISSION
JAN 24 1958
CONSERVATION DIVISION
Wichita, Kansas

01-24-1958

(If additional description is necessary, use BACK of this sheet)

Name of Plugging Contractor _____
Address _____

STATE OF KANSAS, COUNTY OF RUSSELL, ss.
Harold Wurst (employee of owner) or (~~owner~~) of the above-described well, being first duly sworn on oath, says: That I have knowledge of the facts, statements, and matters herein contained and the log of the above-described well as filed and that the same are true and correct. So help me God.

(Signature) Harold Wurst
Russell, Kansas
(Address)

SUBSCRIBED AND SWORN TO before me this 23rd day of January, 19 58

My commission expires 6/17/58 _____ Notary Public.



11-16-17
78-11-18

15-165-00122-00-00

Bennett & Roberts Drilling Co.
STEGMAN "B" #1

SW SE NW Sec. 11-16-17W
Rush County, Kansas

R.T.D. 3619'

Commenced 1/7/58
Completed 1/17/58

8 5/8" Set @ 1109' w/500 sx cnt.

Top Soil & Post Rock	40'
Shale & Shells	75
Sand	125
Shale & Shells	290
Red Bed & Shale	340
Sand	365
Shale	515
Sand	545
Shale	560
Sand	710
Red Bed	811
Shale & Red Bed	1104
Anhydrite	1148
Shale & Shells, Red Bed	1650
Shale	1850
Shale & Lime	2110
Lime	2330
Shale & Lime Streaks	2440
Lime & Shale	2490
Shale	2910
Shale & Lime	3367
Lime	3573
Conglomerate, Arbuckle	3581
Arbuckle	3619

RECEIVED
STATE CORPORATION COMMISSION

JAN 24 1958

CONSERVATION DIVISION
Wichita, Kansas

01-24-1958

STATE OF KANSAS)
RUSSELL COUNTY) SS.

I hereby certify that the above is true and correct to the best of my knowledge.

BENNETT & ROBERTS DRILLING CO.

By Eric Lake

Subscribed and sworn to before me this 23rd day of January, 1958.

Clara Hummel
Notary Public

My Commission Expires 6/17/58

PLUGGING
FILE SEC 11 T 16R17W
BOOK PAGE 78 LINE 18