


STATE OF KANSAS
STATE CORPORATION COMMISSION

Give All Information Completely
Make Required Affidavit
Mail or Deliver Report to:
Conservation Division
State Corporation Commission
800 Bittling Building
Wichita, Kansas

15-165-00007 - 00-00
WELL PLUGGING RECORD

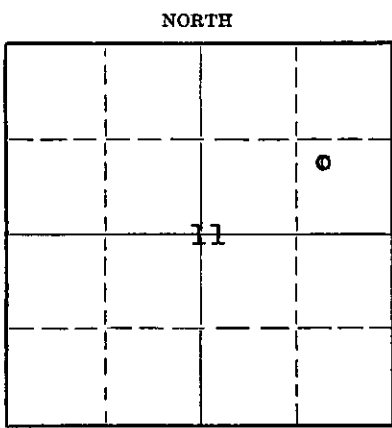

Locate well correctly on above Section Plat

Rush County, Sec. 11 Twp. 16S Rge. 17 (X) W. (W)
Location as "NE/CNW $\frac{1}{4}$ SW $\frac{1}{4}$ " or footage from lines NW SE NE
Lease Owner Northern Pump Company
Lease Name Stegman Well No. 1
Office Address Box 317, Great Bend, Kansas
Character of Well (completed as Oil, Gas or Dry Hole) Oil
Date well completed August 5, 1952 19 52
Application for plugging filed January 9, 19 53
Application for plugging approved 19
Plugging commenced January 9 19 53
Plugging completed January 16 19 53
Reason for abandonment of well or producing formation Dry

If a producing well is abandoned, date of last production October 29 19 52
Was permission obtained from the Conservation Division or its agents before plugging was commenced? Yes

Name of Conservation Agent who supervised plugging of this well C. D. Stough
Producing formation Lansing Depth to top 3376 Bottom 3383 Total Depth of Well 3524 Feet
Show depth and thickness of all water, oil and gas formations.

OIL, GAS OR WATER RECORDS

CASING RECORD

Formation	Content	From	To	Size	Put In	Pulled Out
Topeka	2938 -1020			8-5/8"	1064'	None
Heebner	3170 -1252					
Lansing	3224 -1306			5 1/2"	3518'	None
Chert Conglomerate	3501 -1583					
Arbuckle	3516 -1598					

Describe in detail the manner in which the well was plugged, indicating where the mud fluid was placed and the method or methods used in introducing it into the hole. If cement or other plugs were used, state the character of same and depth placed, from _____ feet to _____ feet for each plug set.

Spotted 50 foot of cement from 2934 feet to 2884 feet - filled hole with heavy laden mud - circulated 125 sacks cement from 400 feet to surface between 5 1/2 inch and 8-5/8 inch casing. Hole filled to top.

01-19-1953

(If additional description is necessary, use BACK of this sheet)
Name of Plugging Contractor Northern Pump Company
Address Box 317, Great Bend, Kansas

STATE OF Kansas COUNTY OF Barton, ss.
L. F. Browning (employee of owner) or (owner or operator) of the above-described well, being first duly sworn on oath, says: That I have knowledge of the facts, statements, and matters herein contained and the log of the above-described well as filed and that the same are true and correct. So help me God.

(Signature) L. F. Browning, General Supt.
Box 317, Great Bend, Kansas (Address)

SUBSCRIBED AND SWORN to before me this 17 day of January, 19 53

My commission expires October 23, 1954

Notary Public.

PLUGGING
FILE SEC 11 T 16 R 17
BOOK PAGE 21 LINE 30

Contractor:
Hilton Drilling Co., Inc.

Northern Pump Company
Stegman # 1
NW SE NE Sec. 11-T16S-R17W
Rush County, Kansas

Elevation: Ground 1914'
D.F. 1916'

TOTAL DEPTH: 3524'
T.P.B.D.: 3460'
Commenced: July 7, 1952
Completed: Aug. 5, 1952
Casing: 8-5/8" - 1064' - 525 sacks cement
5-1/2" - 3518' - 200 sacks cement

Post Rock	41
Post Rock, Shale, and Shells	95
Broken Rock, Shale, and Shells	170
Shale and Shells	215
Sand	260
Sand, Shale, and Shells	360
Shale and Shells	455
Sand	640
Shale, Shells, and Red Bed	735
Shale and Shells	1015
Red Bed, Shale, and Shells	1053
Anhydrite	1085
Red Bed	1100
Red Bed, Shale, and Shells	1410
Lime and Shale	1935
Lime	2435
Shale and Lime	2610
Lime Broken	2680
Lime and Shale	2950
Lime	3089
Lime and Shale	3117
Lime	3456
Lime and Shale	3489
Conglomerate and Lime	3507
Shale and Lime	3520
Lime	3524
TOTAL DEPTH	3524

Tops:

Topeka	2938	(-1020)
Heebner	3170	(-1252)
Lansing	3224	(-1306)
Chert Conglomerate	3501	(-1583)
Arbuckle	3516	(-1598)

PLUGGING
WELL SEC 11 T 16 S 17 W
BOOK PAGE 21 LINE 30