


WELL PLUGGING RECORD

15-145-21069-00-00

Give All Information Completely
 Make Required Affidavit

COUNTY Rush SEC. 11 TWP. 16 RGE. 17W ~~E/W~~
 Location as in quarters or footage from lines:
 SW NE NW

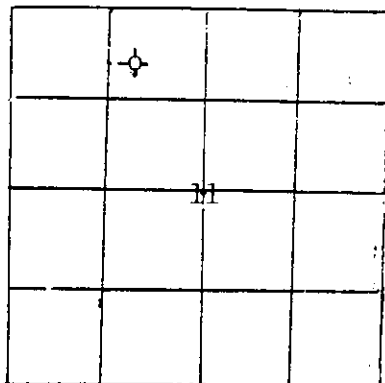

Lease Owner Energy Reserves Group, Inc.
 Lease Name Stegman Well No. 3
 Office Address 925 Patton Road, Great Bend, Kansas 67530
 Character of Well (Completed as Oil, Gas or Dry Hole): Dry Hole
 Date Well Completed 2/25/83
 Application for plugging filed 2/25/83
 Plugging commenced 2/25/83
 Plugging completed 2/25/83 11 p.m.
 Reason for abandonment of well or producing formation

Locate Well
 correctly on above
 Section Platt.

Non-Commercial
 Was permission obtained from the Conservation Division or it's
 Agent's before plugging was commenced? yes

Name of Conservation Agent who supervised plugging of this well Bob Tarbutton

Producing formation None Depth to top bottom T.D. 3635

Show depth and thickness of all water, oil and gas formations.

OIL, GAS OR WATER RECORDS

Casing Record

Formation	Content	From	To	Size	Put in	Pulled Out
Surface - Anhydrite	Surf. Casing	0	1132'	8-5/8	yes	no

Describe in detail the manner in which the well was plugged, indicating where the mud fluid was placed and the method or methods used in introducing it into the hold. If cement or other plugs were used, state the character of same and depth placed, from feet to feet for each plug set.

1st plug @ 3538' with 50 sacks 50/50 Poz, 2% gel, 2% CC
2nd plug @ 1170' with 50 sacks " " " "
3rd plug @ 600 with 40 sack " " " "
Solid bridge @ 40' with 10 sacks " " " "
15 sacks in rat hole
Job completed @ 11 p.m. 2/25/83


(If additional description is necessary, use BACK of this sheet)

Name of Plugging Contractor Halliburton Cement

STATE OF Kansas COUNTY OF Rush, ss.

Jim W. Sullivan (~~employee of owner~~ or (~~owner~~ or operator) of the above-described well, being first duly sworn on oath, says: That I have knowledge of the facts, statements, and matters herein contained and the log of the above-described well as filed and that the same are true and correct. So help me God.

(Signature) Jim W. Sullivan
925 Patton Rd, Great Bend, KS 67530
 (Address)

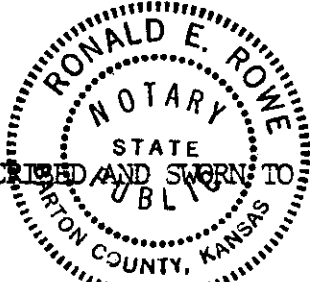

SUBSCRIBED AND SWORN TO before me this 17th day of March, 19 83

Ronald E. Rowe
 Notary Public

My Commission expires My Appointment Expires Sept. 9, 1983

STATE CORPORATION COMMISSION
 03-21-1983
 MAR 21 1983
 CONSERVATION DIVISION
 Wichita, Kansas