


STATE OF KANSAS
STATE CORPORATION COMMISSION

15-165-00087-00-00
WELL PLUGGING RECORD

Give All Information Completely
Make Required Affidavit
Mail or Deliver Report to:
Conservation Division
State Corporation Commission
211 No. Broadway
Wichita, Kansas

Rush County. Sec. 15 Twp. 16 Rge. 17W (E) (W)
Location as "NE/CNWSW" or footage from lines SW SW NE
Lease Owner Woodman & Iannitti Drilling Co.
Lease Name Burgardt Well No. 1
Office Address P. O. Box 387, Hoisington, Kansas
Character of Well (completed as Oil, Gas or Dry Hole) Dry Hole
Date well completed 9-12 19 56
Application for plugging filed 9-14 19 56
Application for plugging approved " 19
Plugging commenced " 19
Plugging completed " 19
Reason for abandonment of well or producing formation Dry
If a producing well is abandoned, date of last production 19
Was permission obtained from the Conservation Division or its agents before plugging was commenced? Yes

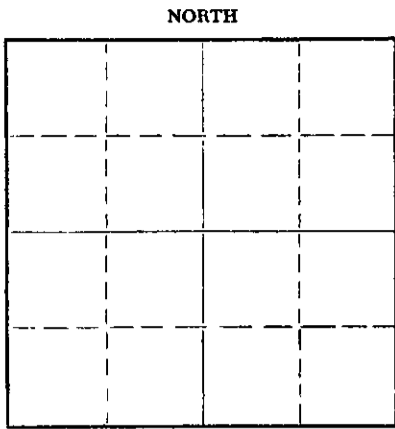

Locate well correctly on above Section Plat

Name of Conservation Agent who supervised plugging of this well R. M. Brundege
Producing formation _____ Depth to top _____ Bottom _____ Total Depth of Well 3916 Feet
Show depth and thickness of all water, oil and gas formations.

OIL, GAS OR WATER RECORDS

CASING RECORD

FORMATION	CONTENT	FROM	TO	SIZE	PUT IN	PULLED OUT
				8 5/8"	293	

Describe in detail the manner in which the well was plugged, indicating where the mud fluid was placed and the method or methods used in introducing it into the hole. If cement or other plugs were used, state the character of same and depth placed, from _____ feet to _____ feet for each plug set.
Jet pits with heavy mud, plug at 270, 1/3 sack of hulls. 20 sacks of cement, plug 40'
1/3 sack of hulls, 10 sacks of cement.

RECEIVED
STATE CORPORATION COMMISSION
SEP 15 1959
CONSERVATION DIVISION
WELL PLUGGING
09-15-1954

(If additional description is necessary, use BACK of this sheet)
Name of Plugging Contractor Woodman & Iannitti
Address P. O. Box 387, Hoisington, Kansas

STATE OF Kansas, COUNTY OF Sedgwick, ss.
K. T. Woodman (employee of owner) or (owner or operator) of the above-described well, being first duly sworn on oath, says: That I have knowledge of the facts, statements, and matters herein contained and the log of the above-described well as filed and that the same are true and correct. So help me God.

(Signature) K. T. Woodman

SUBSCRIBED AND SWORN TO before me this 14th day of September, 19 56

Lucille E. Arrington
Lucille E. Arrington, Notary Public.

My commission expires November 30, 1959

PLUGGING
FILE SEC 15 T 16 R 17W
BOOK PAGE 98 LINE 33

15-165-00087-00-00

DRILLING LOG

Company: Aurora Gasoline and Woodman & Iannitti Drilling Co.
 Lease: Burgardt
 Well: #1 Burgardt SW SW NE 15-16-17W, Rush County, Kansas
 Contractor: Woodman & Iannitti Drilling Co.
 P. O. Box 387, Hoisington, Kansas
 Date Comm: 8-31-56
 Date Compl: 9-12-56
 T. D. 3619'
 Casing: 293' 8 5/8" surface casing

Figures Indicate the Bottom of Formation

0-40	Clay	3300	Lime & Shale
90	Clay	3347	Line
293	Shale & Shells	3385	Line
555	Shale & Shells	3435	Line
800	Dakota Sand	3485	Line
820	Red Bed & Shale	3532	Line
1012	Red Bed & Shale	3556	Lime & Shale
1155	Sand & Red Bed	3565	Arb.
1192	Anhydrite & Hard	3579	Line
1197	Shale & Shells	3619	Arb.
1275	Shale & Red Bed	3619	Total Depth
1335	Red Bed & Shale		
1400	Shale & Shells		
1650	Shale & Shells		
1864	Shale & Shells		
1915	Bro. Lime & Shale		
2065	Bro. Lime & Shale		
2075	Lime & Shale		
2290	Shale & Bentnight		
2218	Shale & Bentnight		
2253	Lime & Shale		
2335	Lime & Shale		
2400	Lime & Shale		
2435	Shot & Lime		
2485	Shale & Lime		
2500	Lime & Shale		
2575	Shale & Shells		
2605	Lime & Shale		
2675	Line		
2750	Line		
2830	Lime & Shale		
2890	Line		
3015	Line		
3100	Lime & Shale		
3148	Line		
3230	Lime & Shale		

Following Tops have been adjusted to Rotary Bushing & Haliburton Guard Log

Elevation	2006	
Dakota Sand		/ 451
Anhydrite	1155	/ 851
Heebner	3247	- 1241
Toronto	3268	- 1262
Lansing	3297	- 1291
Arbuckle	3552	- 1546
Total Depth	3619	- 1613

I certify the attached is a true and correct copy of the Driller's Log on the #1 Burgardt SW SW NE 15-16-17W, Rush County, Kansas.

RECEIVED
 STATE OF KANSAS
 09-15-1956
 COUNTY OF RUSH

WOODMAN & IANNITTI DRILLING CO.

By: *K. T. Woodman*

K. T. Woodman

PLUGGING			
FILE	SEC 15	T. 16	R. 17W
BOOK	PAGE 98	LINE 33	