


STATE OF KANSAS
STATE CORPORATION COMMISSION

Give All Information Completely
Make Required Affidavit
Mail or Deliver Report to:
Conservation Division
State Corporation Commission
P. O. Box 17027
Wichita, Kansas 67217
NORTH

15-101-20563-0000
WELL PLUGGING RECORD

Form CP-4

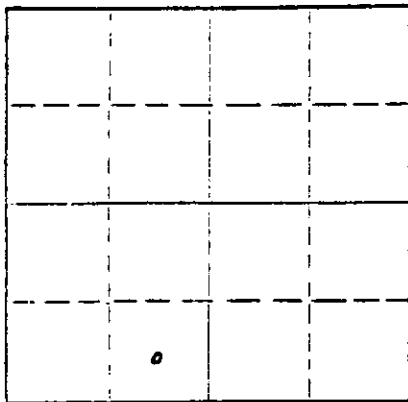

Locate well correctly on above
Section Plat

Lane _____ County. Sec. 10 Twp. 20 Rge. _____ (E) 28W (W)
Location as "NE/CNW/SW" or footage from lines 1980' FWL & 500' FSL
Lease Owner DONALD C. SLAWSON
Lease Name Whiting 'A' Well No. 1
Office Address 200 Douglas Building Wichita, Kansas 67202
Character of Well (completed as Oil, Gas or Dry Hole) Dry Hole
Date well completed August 25, 1981
Application for plugging filed August 25, 1981
Application for plugging approved August 25, 1981
Plugging commenced August 25, 1981
Plugging completed August 25, 1981
Reason for abandonment of well or producing formation Dry Hole

If a producing well is abandoned, date of last production _____ 19____
Was permission obtained from the Conservation Division or its agents before plugging was commenced? Yes

Name of Conservation Agent who supervised plugging of this well Gilbert Balthazor
Producing formation _____ Depth to top _____ Bottom _____ Total Depth of Well 2250 Feet
Show depth and thickness of all water, oil and gas formations.

OIL, GAS OR WATER RECORDS

CASING RECORD

FORMATION	CONTENT	FROM	TO	SIZE	PUT IN	PULLED OUT
		surface	254'	8 5/8"		
	<u>11-6-81</u>					

Describe in detail the manner in which the well was plugged, indicating where the mud fluid was placed and the method or methods used in introducing it into the hole. If cement or other plugs were used, state the character of same and depth placed, from _____ feet to _____ feet for each plug set.

1st plug @ 800' w/60 sx
2nd plug @ 240' w/40 sx
Bridge @ 40' w/10 sx
5 sx in Rat Hole

(If additional description is necessary, use BACK of this sheet)


Name of Plugging Contractor Allied Cementing Co., Inc.
Address Box 31 Russell, Kansas 67665

STATE OF KANSAS COUNTY OF SEDGWICK ss.
William R. Horigan (employee of owner) or (owner or operator) of the above-described well, being first duly sworn on oath, says: That I have knowledge of the facts, statements, and matters herein contained and the log of the above-described well as filed and that the same are true and correct. So help me God.

(Signature) William R. Horigan
200 Douglas Building Wichita, Kansas 67202
(Address)

SUBSCRIBED AND SWORN to before me this 31st day of October, 19 81

My commission expires 06/12/82

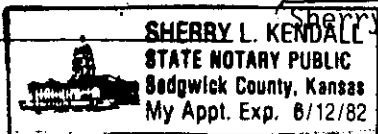

Sherry L. Kendall Notary Public.