

STATE OF KANSAS
STATE CORPORATION COMMISSION

WELL PLUGGING RECORD


Give All Information Completely
Make Required Affidavit
Mail or Deliver Report to
Conservation Division
State Corporation Comm.
245 North Water
Wichita, KS 67202

Barber County, Sec. 34 Twp. 31S Rge. 11 E/W
Location as "NE/CNW $\frac{1}{4}$ SW $\frac{1}{4}$ " or footage from lines
C NE $\frac{1}{4}$ SE $\frac{1}{4}$

Lease Owner Hummon Corporation
Lease Name Chapin Well No. 1-34

Office Address 400 One Main Place, Wichita, KS 67202
Character of Well (Completed as Oil, Gas or Dry Hole)
Dry Hole (c)(L)

Date Well completed May 3 1983
Application for plugging filed May 3 1983
Application for plugging approved May 3 1983
Plugging commenced May 3 1983
Plugging completed May 4 1983
Reason for abandonment of well or producing formation

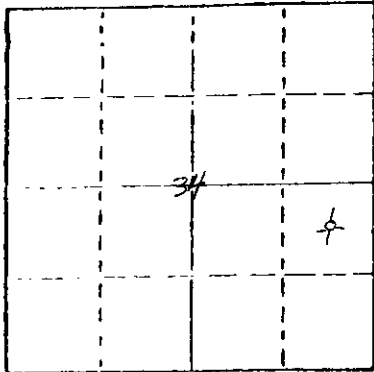

Locate well correctly on above
Section Plat

If a producing well is abandoned, date of last production
19

Was permission obtained from the Conservation Division or
its agents before plugging was commenced? Yes

Name of Conservation Agent who supervised plugging of this well KCC office @ Dodge City, KS
Producing formation Depth to top Bottom Total Depth of Well 4761
Show depth and thickness of all water, oil and gas formations.

OIL, GAS OR WATER RECORDS

CASING RECORD

FORMATION	CONTENT	FROM	TO	SIZE	PUT IN	PULLED OUT
Surface	Surface	0	225	8-5/8"	Yes	No

Describe in detail the manner in which the well was plugged, indicating where the mud fluid
was placed and the method or methods used in introducing it into the hold. If cement or other
plugs were used, state the character of same and depth placed, from feet to
feet for each plug set.

1st plug @ 575' w/ 50 sx.
2nd plug @ 240' w/ 40 sx.
Bridge @ 40' w/ 10 sx.
15 sx. in rathole
10 sx. in mousehole
Job complete @ 1:00 a.m. 5-4-83.

(If additional description is necessary, use BACK of this sheet)

Name of Plugging Contractor Big-H Drilling, Inc.

STATE OF KANSAS COUNTY OF SEDGWICK, ss.
Wilber Berg of Hummon Corporation (employee of owner) or (owner or operator)
of the above-described well, being first duly sworn on oath, says: That I have knowledge of
the facts, statements, and matters herein contained and the log of the above-described well
as filed and that the same are true and correct. So help me God.

(Signature) Wilber D Berg
400 One Main Place, Wichita, KS 67202
(Address)

SANDRA E. MENDOZA
STATE NOTARY PUBLIC
SEDGWICK COUNTY, KANSAS
MY APPT. EXP.

TO before me this 9th day of May, 19 83

Sandra E. Mendoza
Notary Public.

My commission expires 2/13/86

RECEIVED
STATE CORPORATION COMMISSION

MAY 16 1983
5-16-83
CONSERVATION DIVISION
Wichita, Kansas