

15-007-30281-0000

STATE OF KANSAS
STATE CORPORATION COMMISSION

Give All Information Completely
Make Required Affidavit
Mail - Deliver Report to:
Conservation Division
State Corporation Commission
1001 N. Broadway
Wichita, Kansas

WELL PLUGGING RECORD

Barber County. Sec. 8 Twp. 31S Rge. 11W (E) (W)

Location as "NE/CNW/SW" or footage from lines C SE/4 NW/4

Lease Owner Bowers Drilling Company, Inc.

Lease Name Axline Well No. B#1

Office Address 1434 Wichita Plaza, Wichita, Kansas

Character of Well (completed as Oil, Gas or Dry Hole) Dry Hole

Date well completed December 18, 1966

Application for plugging filed December 27, 1966

Application for plugging approved December 18, 1966

Plugging commenced December 18, 1966


Plugging completed December 18, 1966

Reason for abandonment of well or producing formation Dry

If a producing well is abandoned, date of last production _____ 19____

Was permission obtained from the Conservation Division or its agents before plugging was commenced? Yes, verbally

NORTH

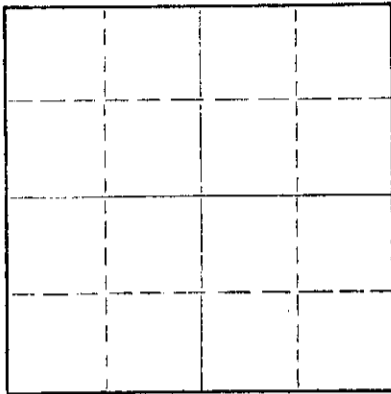

Locate well correctly on above Section Plat

Name of Conservation Agent who supervised plugging of this well _____

Producing formation _____ Depth to top _____ Bottom _____ Total Depth of Well 4470 Feet

Show depth and thickness of all water, oil and gas formations.

OIL, GAS OR WATER RECORDS

CASING RECORD

FORMATION	CONTENT	FROM	TO	SIZE	PUT IN	PULLED OUT
				8-5/8"	290'	None

Describe in detail the manner in which the well was plugged, indicating where the mud fluid was placed and the method or methods used in introducing it into the hole. If cement or other plugs were used, state the character of same and depth placed, from _____ feet to _____ feet for each plug set.

Filled hole with mud to 290'
Set first plug at 290' with 1 sack gel,
1 sack hulls, and 35 sacks cement
Filled hole to 40'
Set second plug at 40' with 1 sack gel,
1 sack hulls, and 10 sacks cement

DEC 29 1966
12-29-66
CONSERVATION DIVISION
Wichita, Kansas

(if additional description is necessary, use BACK of this sheet)

Name of Plugging Contractor Bowers Drilling Company, Inc.
Address 1434 Wichita Plaza, Wichita, Kansas

STATE OF KANSAS, COUNTY OF SEDGWICK, ss.

(~~employee of owner~~) or (owner or operator) of the above-described well, being first duly sworn on oath, says: That I have knowledge of the facts, statements, and matters herein contained and the log of the above-described well as filed and that the same are true and correct. So help me God.

(Signature) Emil E. Roman
1434 Wichita Plaza, Wichita, Kansas
(Address)

SUBSCRIBED AND SWORN TO before me this 27th day of December 1966

Elaine L. Winter
Notary Public

My commission expires May 5, 1970.

WELL LOG

COMPANY: Bowers Drilling Company, Inc.
 CONTRACTOR: Bowers Drilling Company, Inc.
 FARM: Axline B#1
 LOCATION: Center SE/4 NW/4 Section 8-31S-11W
 Barber County, Kansas
 COMMENCED: 12-7-66
 COMPLETED: 12-18-66
 ELEVATION: 1730 Kelly Bushing

0 - 525	Redbed	Set 293' of 8-5/8" surface casing
525 - 1321	Shale	
1321 - 1780	Anhydrite	
1780 - 2290	Shale and Lime	
2290 - 2475	Lime	
2475 - 2575	Lime and Shale	
2575 - 2875	Shale	
2875 - 3910	Lime and Shale	
3910 - 4366	Lime	
4366 - 4421	Lime and Shale	
4421 - 4470	Lime	
4470	T.D.	

LOG TOPS

Elgin Zone	3498 (-1768)
Elgin Sand	3540 (-1810)
Heebner	3652 (-1922)
Douglas Sand	3769 (-2039)
Lansing	3847 (-2117)
Mississippian	4396 (-2666)
Log T.D.	4467 (-2737)

STATE OF KANSAS)
) SS
 COUNTY OF SEDGWICK)

I, Emil E. Bowers, do hereby certify that the above and foregoing is a true and correct copy of the log of the Axline B#1 located Center SE/4 NW/4 Section 8-31S-11W, Barber County, Kansas, as reflected by the files of Bowers Drilling Company, Inc.

Emil E. Bowers

Subscribed and sworn to before me, a Notary Public, in and for Sedgwick County, Kansas, this 27th day of December, 1966.

Elaine L. Winter

My commission expires May 5, 1970.