

WELL PLUGGING RECORD

OR

FORMATION PLUGGING RECORD

Strike out upper line when reporting plugging off formations.

STATE OF KANSAS STATE CORPORATION COMMISSION

Give All Information Completely Make Required Affidavit Mail or Deliver Report to: Conservation Division State Corporation Commission 800 Biting Building Wichita, Kansas

Barber County, Sec. 16 Twp. 31S Rge. (E) 11(W)

Location as "NE 1/4 NW 1/4 SW 1/4" or footage from lines C NE NE 1/4

Lease Owner OLSON OIL COMPANY

Lease Name L. M. Axline Well No. 1

Office Address Drawer 2680, Tulsa, Okla.

Character of Well (completed as Oil, Gas or Dry Hole) Dry hole

Date, well completed 12 - 13 - 19 42

Application for plugging filed 12 - 21 - 19 42

Application for plugging approved 12 - 22 - 19 42


Plugging Commenced 1 - 2 - 19 43

Plugging Completed 1 - 9 - 19 43

Reason for abandonment of well or producing formation Dry hole

If a producing well is abandoned, date of last production 19

Was permission obtained from the Conservation Division or its agents before plugging was commenced? Yes. C. T. Alexander

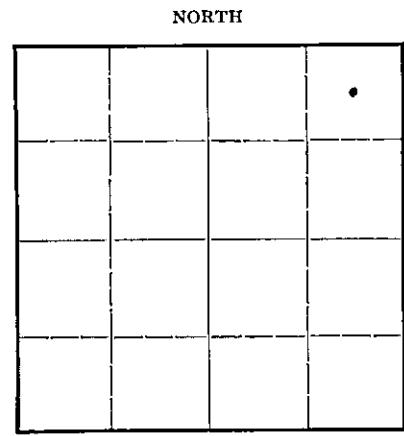

Locate well correctly on above Section Plat

Name of Conservation Agent who supervised plugging of this well C. T. Alexander

Producing formation Depth to top Bottom Total Depth of Well 5097 Feet

Show depth and thickness of all water, oil and gas formations.



OIL, GAS OR WATER RECORDS

CASING RECORD

Table with 7 columns: Formation, Content, From, To, Size, Put In, Pulled Out. Rows include Chat (Water, 4505, 10 3/4, 141, None) and Viola (Water, 4772, 5 3/16, 4512, 3976 ft.).

Describe in detail the manner in which the well was plugged, indicating where the mud fluid was placed and the method or methods used in introducing it into the hole. If cement or other plugs were used, state the character of same and depth placed, from feet to feet for each plug set.

TOTAL DEPTH 5097 ft. Hole plugged back to 4590 ft. with 100 sacks of cement. Dumped 13 sacks of cement which filled hole to 4492. Filled hole with mud to 4290. Dumped 2 sacks of cement which filled to 4190. Filled hole with mud to 141 ft. Set Bridge at 141 ft. and dumped 20 sacks of cement which filled to 121 ft. Mudded hole to 8 ft. of base of cellar. Filled last 8 ft. to base of cellar with cement.

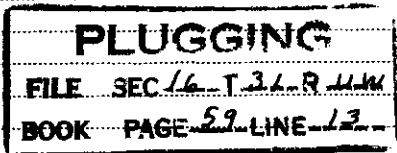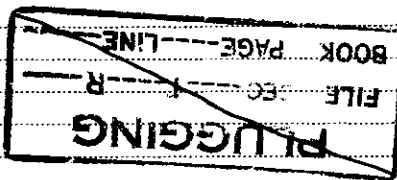

(If additional description is necessary, use BACK of this sheet)

Correspondence regarding this well should be addressed to S. A. Keefover R. F. D. # 1 (Olson Oil Co.) Burrton, Kansas 1-14-43

STATE OF Kansas, COUNTY OF Harvey, ss. G. F. Bryant (employee of owner) or (representative) of the above-described well,

being first duly sworn on oath, says: That I have knowledge of the facts, statements, and matters herein contained and the log of the above-described well as filed and that the same are true and correct. So help me God.

(Signature) G. F. Bryant

(Address)

SUBSCRIBED AND SWORN to before me this 11th day of January, 19 43

My commission expires July 22, 1944

(Signature) A. L. [unreadable] Notary Public.

OLSON OIL COMPANY  
 L. M. Axline # 1  
 C NE NE/4, Sec. 16-31S-11W  
 Barber County, Kansas

COMMENCED 10 - 21 - 42  
 COMPLETED 12- 13 - 42

0				
145	Sand & gravel	4527	Cored, soft.	
164	Shale & shells	4566	Limey chat & chert, soft	
311	Sandy shale & shells	4585	Chert & shale	
680	Red bed & shells	4600	Shale	
1120	Sand & shale	4615	Chert & shale	
1450	Shale & shells	4643	Chert, hard	
1545	Shells, salt & shale	4687	Shale	
1580	Shale & shells	4725	Shale & lime breaks	
1786	Shale & salt	4771	Shale & shells	
2004	Anhydrite	4793	Cherty lime	
2064	Shale & Gyp	4808	Lime & chert	
2222	Anhydrite & shale	4817	Hard sandy lime	
2260	Sandy lime	4828	Chert & lime, hard	
2304	Shale & shells	4838	Lime, hard	
2542	Lime & shale	4870	Lime, broken with sand	
2558	Lime, hard	4874	Lime, hard	
2706	Lime & shale	4908	Shale, streaks of sand	
2748	Lime	4944	Shale	
2771	Shale	4971	Shale & shells	
2939	Lime & shale	5017	Lime	
2988	Shale & lime shells	5022	Chert, hard	
3115	Lime & shale	5032	Shale & chert shells	
3170	Lime & shale	5057	Lime, dense-rough-hard	
3200	Lime, white, porous	5080	Lime & green shale	
3205	Shale	5097 1/2	Dolomite	
3383	Lime		TOTAL DEPTH	
3489	Shale			
3564	Shale & shells			
3644	Shale			
3650	Sand, soft			
3691	Shale & lime			
3820	Shale			
3859	Lime, hard			
3862	Broken lime with shale			
3907	Sand, med. hard to soft			
3926	Shel & lime shells			
4267	Lime			
4319	Lime & shale			
4356	Lime			
4505	Lime & shale			
4509	Chert, soft			

CASING RECORD

10 3/4"	35#	L.W.	141'
5 1/2"	14 & 17#	S.S.	4499'

**PLUGGING**  
 FILE SEC 16-T-31R 11W  
 BOOK PAGE 59 LINE 13

1-14-43

Subscribed and sworn to before me  
 this 11th day of January 1943

*A. P. Hildebrandt*

Notary Public

I hereby certify that the above is  
 a true and correct copy of the log of  
 L. M. Axline # 1, C NE NE/4,  
 Sec. 16-31S-11W, Barber County, Kansas

*L. J. Bryant*

My Commission Expires July 22, 1944