


STATE OF KANSAS
STATE CORPORATION COMMISSION

Give All Information Completely
Make Required Affidavit
Mail or Deliver Report to:
Conservation Division
State Corporation Commission
P. O. Box 17027
Wichita, Kansas 67217
MONTH

15-165-02018-00-01
WELL PLUGGING RECORD

Form CP-4

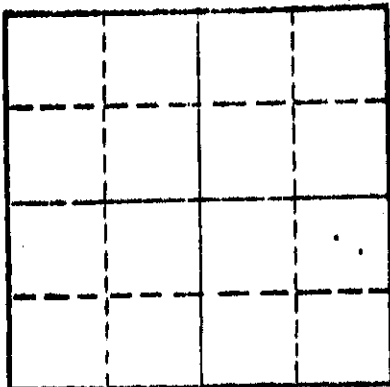

Locate well correctly on above Section Plat

Location as "NE/CNW/SE/SW" or footage from lines SW SW SW
County, Sec. 35 Twp. 16 Rge. 17 (E) (W)
Lease Owner Frontier Oil Company
Lease Name Shank #2 Well No. _____
Office Address Wichita, Kansas 67202
Character of Well (completed as Oil, Gas or Dry Hole) _____
Date well completed _____ 10
Application for plugging filed _____ 10
Application for plugging approved _____ 10
Plugging commenced 11/6/73 _____ 10
Plugging completed 11/10/73 _____ 10
Reason for abandonment of well or producing formation depleted.
If a producing well is abandoned, date of last production _____ 10
Was permission obtained from the Conservation Division or its agents before plugging was commenced? yes

Name of Conservation Agent who supervised plugging of this well Massey
Producing formation _____ Depth to top _____ Bottom _____ Total Depth of Well 3568 Feet
Show depth and thickness of all water, oil and gas formations.

OIL, GAS OR WATER RECORDS

CASING RECORD

| FORMATION | CONTENT | FROM | TO | SIZE | PUT IN | PULLED OUT |
|-----------|---------|------|----|--------|--------|------------|
| | | | | 8-5/8 | 200 | none |
| | | | | 4 1/2" | 3567 | 1470' |
| | | | | | | |
| | | | | | | |
| | | | | | | |
| | | | | | | |
| | | | | | | |

Describe in detail the manner in which the well was plugged, indicating where the mud fluid was placed and the method or methods used in introducing it into the hole. If cement or other plugs were used, state the character of same and depth placed, from _____ feet to _____ feet for each plug set.

Checked hole to 3568', ran sand to 3000' and ran 3 sacks of cement. Loaded hole, shot pipe at 1470', pulled 46 joints. Allied pumped 3 sacks hulls, 20 sacks gel and 120 sacks cement.

PLUGGING COMPLETE.

RECEIVED
STATE CORPORATION COMMISSION
DEC 12 1973
CONSERVATION DIVISION
Wichita, Kansas

(If additional description is necessary, use BACK of this sheet)
Name of Plugging Contractor KNIGHT CASING PULLING CO., INC.
Address CHASE, KANSAS

STATE OF KANSAS, COUNTY OF RICE, ss.
NOEL J. KNIGHT (employee of owner) or (owner or operator) of the above-described well, being first duly sworn on oath, says: That I have knowledge of the facts, statements, and matters herein contained and the log of the above-described well as filed and that the same are true and correct. So help me God.

(Signature) Noel Knight
CHASE, KANSAS
(Address)

Subscribed and Sworn to before me this 12th day of November, 1973

Margaret Melcher
Notary Public.

My commission expires _____
MARGARET MELCHER
NOTARY PUBLIC
Rice County, Kansas
My Commission Expires
Feb. 15, 1975