

15-165-20272-00-00


STATE OF KANSAS
STATE CORPORATION COMMISSION

Form CP-4

Give All Information Completely
Make Required Affidavit
Mail or Deliver Report to:
Conservation Division
State Corporation Commission
212 No. Market
Wichita, Kansas

WELL PLUGGING RECORD

NORTH

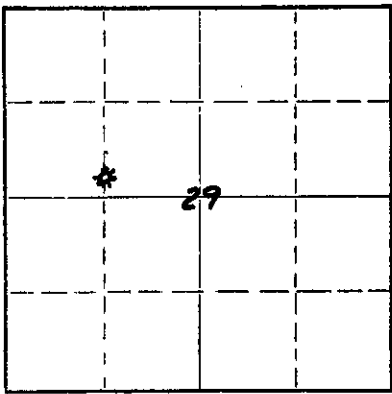

Locate well correctly on above
Section Flat

Rush County. Sec. 29 Twp. 16S Rge. 17 (E) 17 (W)
Location as "NE/CNW/SW" or footage from lines S 1/2, S 1/2, NW
Lease Owner Frontier Oil Co.
Lease Name Hoffman Well No. 2
Office Address 1720 Wichita Plaza
Character of Well (completed as Oil, Gas or Dry Hole) Gas
Date well completed 12-6 1969
Application for plugging filed 9-27 1974
Application for plugging approved 2-27 1974
Plugging commenced 10-21 1974
Plugging completed 10-21 1974
Reason for abandonment of well or producing formation Non-commercial

If a producing well is abandoned, date of last production _____ 19____
Was permission obtained from the Conservation Division or its agents before plugging was commenced? Yes

Name of Conservation Agent who supervised plugging of this well Lee Massey
Producing formation Lans. KG Depth to top 3266 Bottom 3493 Total Depth of Well 3535 Feet
Show depth and thickness of all water, oil and gas formations.

OIL, GAS OR WATER RECORDS

CASING RECORD

FORMATION	CONTENT	TO	SIZE	PUT IN	PULLED OUT
			8 5/8"	210'	None.
			4 1/2"	3533'	None.

RECEIVED
STATE CORPORATION COMMISSION
OCT 24 1974
CONSERVATION DIVISION
Wichita, Kansas

10-24-1974

Describe in detail the manner in which the well was plugged, indicating where the mud fluid was placed and the method or methods used in introducing it into the hole. If cement or other plugs were used, state the character of same and depth placed, from _____ feet to _____ feet for each plug set.

Mud 25 cc gal mud, 3 cc balls down 4 1/2' followed by 70 cc cement. Shut in Press 800#


(If additional description is necessary, use BACK of this sheet)

Name of Plugging Contractor Allen Crambling Co.
Address Russell Kas

STATE OF KANSAS, COUNTY OF SEDGWICK, ss.
Maxine V. Starr (employee of owner) or (owner or operator) of the above-described well, being first duly sworn on oath, says: That I have knowledge of the facts, statements, and matters herein contained and the log of the above-described well as filed and that the same are true and correct. So help me God.

(Signature) Maxine V. Starr
1720 Wichita Plaza, Wichita, Kansas
(Address)

Subscribed and sworn to before me this 23rd day of October, 1974

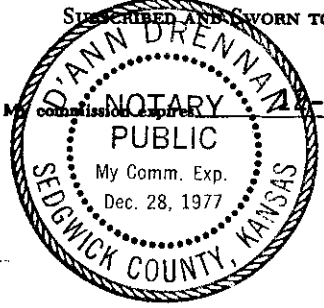

D'Ann Drennan
Notary Public.

15-165-20272-00-00

DRILLERS LOG

No. 2 Hoffman

CASING RECORD:

8 5/8" @ 208'
w/150 sx cement
4 1/2" @ 3533'
w/825 sx cement

COMPANY:

Frontier Oil Company

CONTRACTOR:

Red Tiger Drilling Company

COMMENCED:

November 6, 1969

COMPLETED:

November 18, 1969

DESCRIPTION:

S/2 S/2 NW
29-16S-17W
Rush County,
Kansas

TOTAL DEPTH: 3535'

ELEVATION: 2027 DF
2030 RB

<u>FORMATION</u>	<u>FROM</u>	<u>TO</u>	<u>REMARKS</u>
Clay, Post Rock, Shale	0	210	
Shale	210	515	
Sand	515	770	
Shale	770	1125	
Anhydrite	1125	1156	
Shale	1156	1830	
Lime & Shale	1830	3010	
Lime	3010	3520	
Quartz	3520	3535	

RECEIVED
STATE CORPORATION COMMISSION
SEP 30 1974
CONSERVATION DIVISION
Wichita, Kansas
09-30-1974

I certify that this is a true and correct copy of the above log to the best of my knowledge.

RED TIGER DRILLING COMPANY

Norman E. Klein
Norman E. Klein

Subscribed and sworn to before me this 26th day of November, 1969.



Gloria Fawcett
Notary Public

My Commission Expires:
10/25/72