


15-115-20643-00-01

WELL PLUGGING RECORD

Give All Information Completely
 Make Required Affidavit

COUNTY Rush SEC. 29 TWP. 16S RGE. 17W E/W
 Location as in quarters or footage from lines:
SW SE SE

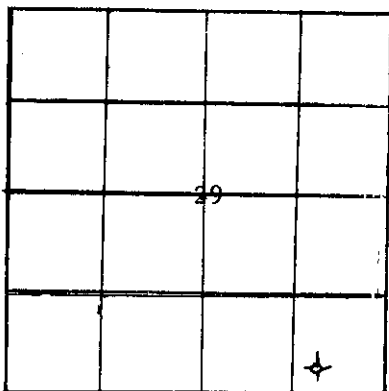

Lease Owner Frontier Oil Company
 Lease Name Janson (Wash Down) Well No. 2
 Office Address Ste 1720, KSB&T Bldg, Wichita, Ks. 67202
 Character of Well (Completed as Oil, Gas or Dry Hole): Dry
 Date Well Completed 11-12-82
 Application for plugging filed 11-11-82
 Plugging commenced 11-12-82
 Plugging completed 11-12-82, 2.30 p.m.
 Reason for abandonment of well or producing formation Dry

Locate Well
 correctly on above
 Section Platt.

Was permission obtained from the Conservation Division or it's
 Agent's before plugging was commenced? Yes

Name of Conservation Agent who supervised plugging of this well Bob Tarbutton
 Producing formation N/A Depth to top _____ bottom T.D.
 Show depth and thickness of all water, oil and gas formations.

OIL, GAS OR WATER RECORDS

Casing Record

Formation	Content	From	To	Size	Put in	Pulled Out
				8-5/8"	252'	None.

Describe in detail the manner in which the well was plugged, indicating where the mud
 fluid was placed and the method or methods used in introducing it into the hold. If cement
 or other plugs were used, state the character of same and depth placed, from _____ feet
 to _____ feet for each plug set.

Plugged at 1178' With 70 sx
 " 775' " 35 "
 " 40' " 10 " 1/2 sx hulls, & plg.
 10 " in Rathole.

Cemented with 125 sx of 50-50 poz , 4% gel 3% cc.
 (calculations by displacement)

(If additional description is necessary, use BACK of this sheet)

Name of Plugging Contractor Allied Cementing Company

STATE OF Kansas COUNTY OF Sedgwick, ss.
George A. Angle (~~employee of owner~~) (owner or operator) of the
 above-described well, being first duly sworn on oath, says: That I have knowledge of the
 facts, statements, and matters herein contained and the log of the above-described well as
 filed and that the same are true and correct. So help me God.

(Signature) George A. Angle
 1720 Ks St Bank Bldg., Wichita Ks
 (Address)

SUBSCRIBED AND SWORN TO before me this 7th day of December 1982



My Commission expires: 5-14-85

