

15-165-30135-00-00


STATE OF KANSAS
STATE CORPORATION COMMISSION

Form CP-4

Give All Information Completely
Make Required Affidavit
Mail or Deliver Report to:
Conservation Division
State Corporation Commission
212 No. Market
Wichita, Kansas

WELL PLUGGING RECORD

Rush County. Sec. 19 Twp. 16S Rge. 17W (E) (W)
Location as "NE/CNW/SW" or footage from lines SE SW NE
Lease Owner Frontier Oil Co
Lease Name TORRY #1 Well No. 1
Office Address 1720 Wichita Plaza Wichita, Kansas
Character of Well (completed as Oil, Gas or Dry Hole) Lost hole
Date well completed 8-26 1966
Application for plugging filed 11-8 1966
Application for plugging approved 11-8 1966
Plugging commenced 11-15 1966
Plugging completed 11-15 1966
Reason for abandonment of well or producing formation Lost hole

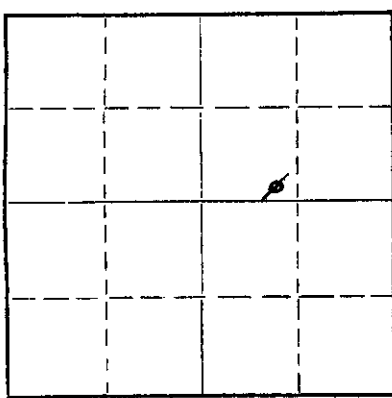

Locate well correctly on above
Section Plat

If a producing well is abandoned, date of last production None 19
Was permission obtained from the Conservation Division or its agents before plugging was commenced? YES

Name of Conservation Agent who supervised plugging of this well Leo Massey
Producing formation Topside & Leasing KC Depth to top 2948 Bottom 3445 Total Depth of Well 3445 Feet
Show depth and thickness of all water, oil and gas formations.

OIL, GAS OR WATER RECORDS

CASING RECORD

FORMATION	CONTENT	FROM	TO	SIZE	PUT IN	PULLED OUT
				8 5/8"	216'	0
				4 1/2"	3444'	0

Describe in detail the manner in which the well was plugged, indicating where the mud fluid was placed and the method or methods used in introducing it into the hole. If cement or other plugs were used, state the character of same and depth placed, from 500' feet to feet for each plug set.

Total depth 3445' 8 5/8" casing set at 216' CWC 4 1/2" casing set at 3444' with 250 sk cement 175 sk cement inside 4 1/2" casing and 75 sk cement outside. Stage collar at 1126' Displaced 150 sk cement between 4 1/2" & 8 5/8" shut in at 300 lbs.

11-15-1966 Mixed to sub's gel mud followed by 50 sacks perma cement down 4 1/2" casing. Maximum pressure 150#. Eased in pressure 100#

DEC 19 1966
12-19-1966
CONSERVATION DIVISION
WICHITA, KANSAS

(If additional description is necessary, use BACK of this sheet)

Name of Plugging Contractor Halleburton
Address Ways, Kansas

STATE OF Kansas COUNTY OF Sedgewick, ss.
Richard Parker (employee of owner) or (owner or operator) of the above-described well, being first duly sworn on oath, says: That I have knowledge of the facts, statements, and matters herein contained and the log of the above-described well as filed and that the same are true and correct. So help me God.

(Signature) Richard Parker
612 Summit, Russell, Kansas (Address)

SUBSCRIBED AND SWORN TO before me this 16th day of December, 1966

My commission expires 5-22-70

Jean Hallan
Notary Public.

15-145-30135-00-00

DRILLERS LOG

TORRY NO. 1

CASING RECORD:	COMPANY:	Frontier Oil Company	DESCRIPTION:
8 5/8" @ 216'	CONTRACTOR:	Red Tiger Drilling Company	SE SW NE
w/135 sx cement	COMMENCED:	August 12, 1966	19-16S-17W
4 1/2" @ 3444'	COMPLETED:	August 20, 1966	Rush Co., Ks.
w/275 sx cement			ELEVATION: 2002 DF
			2005 RB
TOTAL DEPTH:	3445'		

<u>FORMATION</u>	<u>FROM</u>	<u>TO</u>	<u>REMARKS</u>
Post Rock	0	100	
Shale	100	550	
Sand	550	745	
Red Bed	745	1094	
Anhydrite	1094	1134	
Red Bed	1134	1140	
Shale, Shells, & Salt	1140	1460	
Shale & Shells	1460	1803	
Shale & Lime	1803	2390	
Shale & Shells	2390	2580	
Shale & Lime	2580	2965	
Lime	2965	2990	
Lime & Shale	2990	3155	
Lime	3155	3428	
Quartzita	3428	3445	

NOV 4 1966
 11-04-1966
 COMPLETED

I certify that this is a true and correct copy of the above log to the best of my knowledge.

FRONTIER OIL COMPANY

Maxine V. Starr
 Maxine V. Starr

Subscribed and sworn to before me this 29th day of August, 1966.

Dean Holler
 Notary Public

My Commission Expires:
5-22-70