

15-165-20010-00-00


Form CP-1

STATE OF KANSAS
STATE CORPORATION COMMISSION

WELL PLUGGING RECORD

Give All Information Completely
Make Required Affidavit
Mailing Address Report To
Conservation Division
State Corporation Commission

P. O. Box 17027
Wichita, Kansas 67217
NORTH

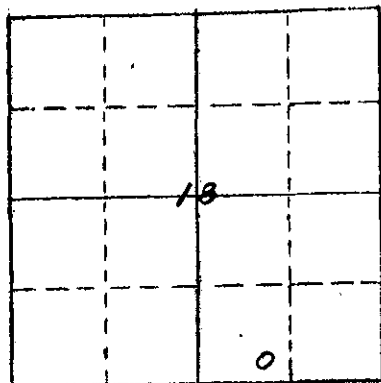

Locate well correctly on above
Section Plat

County, Sec. 18 Twp. 16 Rge. 17 (W)
Location as "NE/CNW/SE" or footage from lines SE SW SE
Lease Owner Frontier Oil
Lease Name Stas Well No. 1
Office Address 1720 Kans. State Bank Bldg. Wichita, Ks.
Character of Well (completed as Oil, Gas or Dry Hole) Gas
Date well completed _____ 19____
Application for plugging filed _____ 19____
Application for plugging approved _____ 19____
Plugging commenced _____ 12-19 1977
Plugging completed _____ 12-19 1977
Reason for abandonment of well or producing formation Non-Commercial

If a producing well is abandoned, date of last production _____ 19____
Was permission obtained from the Conservation Division or its agents before plugging was commenced? Yes

Name of Conservation Agent who supervised plugging of this well Leo Messer
Producing formation Stas Depth to top 3532 Bottom 3538 Total Depth of Well 3538 Feet
Show depth and thickness of all water, oil and gas formations.

OIL, GAS OR WATER RECORDS

CASING RECORD

FORMATION	CONTENT	FROM	TO	SIZE	PUT IN	PULLED OUT
		0	215	8 5/8	215	-0-
		0	3532	4 1/2	3532	-0-

Describe in detail the manner in which the well was plugged, indicating where the mud fluid was placed and the method or methods used in introducing it into the hole. If cement or other plugs were used, state the character of same and depth placed, from _____ feet to _____ feet for each plug set.

DWC @ 1132' / 550 SK cement plug
Went & pumped down 50 SK per cement
3 SK plugs & 25 SK per
Went & pumped 50 SK per cement
Shot in press. 400*

RECEIVED
STATE CORPORATION COMMISSION
DEC 22 1977
12-22-1977
CONSERVATION DIVISION
Wichita, Kansas

Name of Plugging Contractor Alfred Conroy
Address 1720 Kans. St.

STATE OF KANSAS COUNTY OF SEDGWICK
Maxine V. Starr (employee of owner) or (owner or operator) of the above-described

well, being first duly sworn on oath, says: That I have knowledge of the facts, statements, and matters herein contained and the log of the above-described well as filed and that the same are true and correct. So help me God.

(Signature) Maxine V. Starr
1720 Kansas State Bank Building
Wichita, Kansas 67202 (Address)

Subscribed and sworn to before me this 21st day of December, 1977



D'Ann Drennan
Notary Public.

15-165-20010-00-00

DRILLERS LOG

Stos No. 1

CASING RECORD:	COMPANY:	Frontier Oil Company	DESCRIPTION:
8 5/8" @ 215'	CONTRACTOR:	Red Tiger Drilling Co.	SE SW SE
w/140 sx cement	COMMENCED:	February 25, 1967	18-16S-17W
4 1/2" @ 3532'	COMPLETED:	March 8, 1967	Rush Co., Ks.
w/150 sx cement			ELEVATION: 2002 DF
			2005 RB

TOTAL DEPTH: 3538'

<u>FORMATION</u>	<u>FROM</u>	<u>TO</u>	<u>REMARKS</u>
Surface Soil	0	220	
Shale	220	490	
Sand	490	670	
Shale	670	1109	
Anhydrite	1109	1147	
Shale	1147	1640	
Shale & Lime	1640	2935	
Lime	2935	3538	

I certify that this is a true and correct copy of the above log to the best of my knowledge.

FRONTIER OIL COMPANY

Maxine V. Starr
 Maxine V. Starr

Subscribed and sworn to before me this 10th day of March, 1967.

Jean Hollan
 Notary Public

My Commission Expires:

5-22-70

RECEIVED
 STATE CORPORATION COMMISSION
 DEC 15 1977

CONSERVATION DIVISION
 Wichita, Kansas

12-15-1977