


WELL PLUGGING RECORD

Give All Information Completely  
Make Required Affidavit  
Mail or Deliver Report to:  
Conservation Division  
State Corporation Commission  
211 No. Broadway  
Wichita, Kansas

RUSH County. Sec. 17 Twp. 16 Rge. 17 (X) (W)

Location as "NE/CNWxSWx" or footage from lines NW NW NW  
Lease Owner HILTON DRILLING COMPANY, INC.  
Lease Name HARTMAN Well No. 1  
Office Address 925 PATTON, GREAT BEND, KANSAS  
Character of Well (completed as Oil, Gas or Dry Hole) DRY HOLE  
Date well completed NOVEMBER 11, 1958  
Application for plugging filed NOVEMBER 11, 1958  
Application for plugging approved NOVEMBER 11, 1958  
Plugging commenced NOVEMBER 11, 1958  
Plugging completed NOVEMBER 11, 1958  
Reason for abandonment of well or producing formation DRY

NORTH

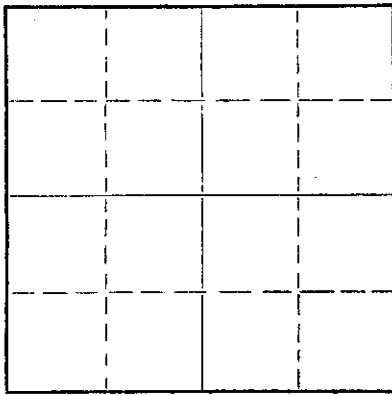

Locate well correctly on above  
Section Plat

If a producing well is abandoned, date of last production 19  
Was permission obtained from the Conservation Division or its agents before plugging was commenced? YES

Name of Conservation Agent who supervised plugging of this well MR. ELDON PETTY  
Producing formation \_\_\_\_\_ Depth to top \_\_\_\_\_ Bottom \_\_\_\_\_ Total Depth of Well 3535 Feet  
Show depth and thickness of all water, oil and gas formations.

OIL, GAS OR WATER RECORDS

CASING RECORD

FORMATION	CONTENT	FROM	TO	SIZE	PUT IN	PULLED OUT
				8 5/8"	1117'	NONE

Describe in detail the manner in which the well was plugged, indicating where the mud fluid was placed and the method or methods used in introducing it into the hole. If cement or other plugs were used, state the character of same and depth placed, from \_\_\_\_\_ feet to \_\_\_\_\_ feet for each plug set.

CEMENTED BOTTOM PLUG @ 400' WITH 20 SACKS CEMENT &  
NEXT PLUG @ 180' WITH 20 SACKS CEMENT, BOTTOM PLUG  
SET @ 40' WITH 10 SACKS OF CEMENT.

(If additional description is necessary, use BACK of this sheet)

Name of Plugging Contractor HILTON DRILLING COMPANY, INC.  
Address 925 PATTON, GREAT BEND, KANSAS

STATE OF KANSAS, COUNTY OF BARTON, ss.  
GEORGE TURNER, DRILLING SUPERINTENDENT (employee of owner) or (~~owner or operator~~) of the above-described well, being first duly sworn on oath, says: That I have knowledge of the facts, statements, and matters herein contained and the log of the above-described well as filed and that the same are true and correct. So help me God.

(Signature) George B Turner  
GREAT BEND, KANSAS  
(Address)

SUBSCRIBED AND SWORN TO before me this 12TH day of NOVEMBER, 19 58

Carmen Feinhardt Leides  
Notary Public

My commission expires JANUARY 26, 1959

PLUGGING  
FILE SEC. 17 T. 16 R. 17W  
BOOK PAGE 14 S LINE 8

11-13-1958  
NOV 13 1958  
CONSERVATION DIVISION  
Wichita, Kansas

DRILLER'S LOG

COMPANY: HILTON DRILLING COMPANY, INC. LOCATION: NW NW NW  
 SECTION 17-16-17  
 CONTRACTOR: HILTON DRILLING COMPANY, INC. RUSH COUNTY, KANSAS  
 FARM NAME: HARTMAN #1 ELEVATION: 2000 DF  
 COMMENCED: OCTOBER 30, 1958 CASING USED: 8 5/8" @ 1117' w/500 SACKS  
 COMPLETED: NOVEMBER 11, 1958

SHALE AND SHELLS	502
SAND AND SHALE	1000
RED BED	1110
ANHYDRITE	1154
RED BED	1205
RED BED AND SHELLS	1320
SHALE AND SHELLS	1670
SHALE, SHELLS AND SALT	1840
LIME AND SHALE	2095
LIME	2375
LIME AND SHALE	2710
SHALE AND SHELLS	2735
LIME AND SHALES	3060
LIME	3250
SHALE	3265
LIME	3296
LIME AND SHALE	3341
LIME	3417
SHALE AND LIME	3439
LIME	3519
QUARTZITE	3535
TOTAL DEPTH	3535

STATE OF KANSAS )  
 ) SS  
 COUNTY OF BARTON )

I, THE UNDERSIGNED, BEING DULY SWORN ON OATH, STATE THAT THE ABOVE STATEMENT AND LOG ARE TRUE AND A CORRECT RECORD AND LOG OF THE WELL DRILLED AT THE LOCATION ABOVE DESCRIBED.

HILTON DRILLING COMPANY, INC.

*Henry Peacock*  
 HENRY PEACOCK - LAND DEPARTMENT

SUBSCRIBED AND SWORN TO BEFORE ME THIS 12TH DAY OF NOVEMBER, 1958

*Carmen Reinhardt Leiber*  
 NOTARY PUBLIC

MY COMMISSION EXPIRES JANUARY 26, 1959.

**RECEIVED**  
 STATE CORPORATION COMMISSION  
 11-14-1958  
 NOV 14 1958

**PLUGGING**  
 FILE SEC. 17 T. 16 R. 17W  
 BOOK PAGE 145 LINE 8

CONSERVATION DIVISION  
 Wichita, Kansas