


Give All Information Completely
• Make Required Affidavit
Mail or Deliver Report to:
Conservation Division
State Corporation Commission
211 No. Broadway
Wichita, Kansas.

15/01-19028
WELL PLUGGING RECORD

Lane _____ County, Sec. 28 Twp. 16S Rge. 27W (E) _____ (W) _____
C NE NW

Location as "NE/CNW/SW" or footage from lines _____
Lease Owner Pet-Ex Company
Lease Name Johnson Well No. 1
Office Address 705 Union Center, Wichita, Kansas
Character of Well (completed as Oil, Gas or Dry Hole) D & A
Date well completed June 27, 1961
Application for plugging filed June 27, 1961
Application for plugging approved June 27, 1961
Plugging commenced June 27, 1961
Plugging completed June 27, 1961
Reason for abandonment of well or producing formation D & A

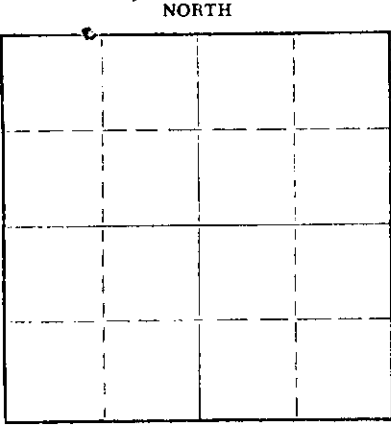

Locate well correctly on above Section Plat

If a producing well is abandoned, date of last production _____ 19____
Was permission obtained from the Conservation Division or its agents before plugging was commenced? Yes

Name of Conservation Agent who supervised plugging of this well Gilbert P. Leiker
Producing formation _____ Depth to top _____ Bottom _____ Total Depth of Well _____ Feet
Show depth and thickness of all water, oil and gas formations.

OIL, GAS OR WATER RECORDS

CASING RECORD

FORMATION	CONTENT	FROM	TO	SIZE	PUT IN	PULLED OUT
				8 5/8	209	-0-

Describe in detail the manner in which the well was plugged, indicating where the mud fluid was placed and the method or methods used in introducing it into the hole. If cement or other plugs were used, state the character of same and depth placed, from _____ feet to _____ feet for each plug set.

Filled hole with heavy mud to 200'. Set plug with 1/2 ex hulls and 20 ex cement. Set top plug at 40' with 1/2 ex hulls and 10 ex cement.

RECEIVED
STATE CORPORATION COMMISSION
OCT 10 1961
10-10-61
CONSERVATION DIVISION
Wichita, Kansas

(If additional description is necessary, use BACK of this sheet)

Name of Plugging Contractor Red Tiger Drilling Company
Address Box 173 - Russell, Kansas

STATE OF KANSAS, COUNTY OF SEDGWICK, ss.
Roy McClure (employee of owner) or (owner) of the above-described well, being first duly sworn on oath, says: That I have knowledge of the facts, statements, and matters herein contained and the log of the above-described well as filed and that the same are true and correct. So help me God.

(Signature) Roy McClure

500 Fourth Nat'l Bank Bldg. Wichita, Kans.
(Address)

SUBSCRIBED AND SWORN TO before me this 20th day of June, 19 61

Marnie Star

Notary Public.

My commission expires 11-17-62

15101-19028-0000

DRILLERS LOG

Johnson No. 1

CASING RECORD: 8 5/8" @ 299' w/200 sx cement
 COMPANY: Pet-Ex Company
 CONTRACTOR: Red Tiger Drilling Co.
 COMMENCED: June 18, 1961
 COMPLETED: June 27, 1961
 DESCRIPTION: C NE NW
 28-16S-27W
 Lane County
 Kansas
 ELEVATION: 2705 DF
 2708 RB
 TOTAL DEPTH: 4350'

<u>FORMATION</u>	<u>FROM</u>	<u>TO</u>	<u>REMARKS</u>
Surface Clay & Sand	0	50	
Clay & Shale	50	110	
Shale	110	600	
Shells & Shale	600	1000	
Sand & Shells	1000	1150	
Shale & Shells	1150	2145	
Anhydrite	2145	2190	
Shale & Shells	2190	2795	
Shale & Lime	2795	3120	
Lime	3120	3178	
Lime & Shale	3178	4175	
Lime	4175	4350	

I certify that this is a true and correct copy of the above log to the best of my knowledge.

RED TIGER DRILLING COMPANY

Roy McClure
Roy McClure

Subscribed and sworn to before me this 29th day of June, 1961.

Mapine Head
Notary Public

My Commission Expires:

11-17-62