


STATE OF KANSAS
STATE CORPORATION COMMISSION

Give All Information Completely
Make Required Affidavit
Mail or Deliver Report to:
Conservation Division
State Corporation Commission
211 No. Broadway
Wichita, Kansas

15-101-19029-0000
WELL PLUGGING RECORD

NORTH

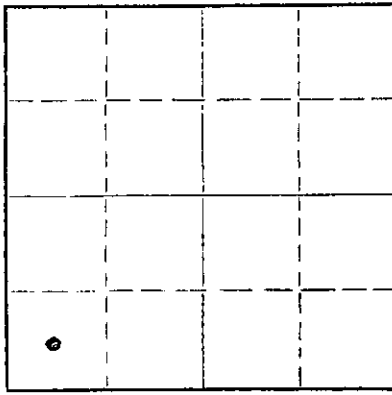

Locate well correctly on above
Section Plat

Lane _____ County. Sec. 28 Twp. 16S Rge. 27 (E) (W)
Location as "NE/CNW%SW%" or footage from lines. C SW SW
Lease Owner Helmerich & Payne, Inc.
Lease Name HALL Well No. 2
Office Address Box 558, Garden City, Kansas
Character of Well (completed as Oil, Gas or Dry Hole) Dry Hole
Date well completed July 19 1962
Application for plugging filed July 19 1962
Application for plugging approved July 19 1962
Plugging commenced July 19 1962
Plugging completed July 19 1962
Reason for abandonment of well or producing formation Dry Hole

If a producing well is abandoned, date of last production _____ 19____
Was permission obtained from the Conservation Division or its agents before plugging was commenced? Yes

Name of Conservation Agent who supervised plugging of this well Eldon Petty Hays, Kansas
Producing formation _____ Depth to top _____ Bottom _____ Total Depth of Well 4605 Feet
Show depth and thickness of all water, oil and gas formations.

OIL, GAS OR WATER RECORDS

CASING RECORD

FORMATION	CONTENT	FROM	TO	SIZE	PUT IN	PULLED OUT
				8-5/8"	284	0

Describe in detail the manner in which the well was plugged, indicating where the mud fluid was placed and the method or methods used in introducing it into the hole. If cement or other plugs were used, state the character of same and depth placed, from _____ feet to _____ feet for each plug set.

4605 to 660 Heavy Rotary Mud
660 to 600 Plug 1/2 sack hulls & 20 sks Pozmix
600 to 280 Heavy Rotary Mud
280 to 223 Plug 1/2 sack hulls & 20 sks Pozmix
223 to 40 Heavy Rotary Mud
40 to 4 Plug 1/2 sks hulls & 15 sks Pozmix
4 to 0 Collar

Plugging Complete @ 7:00 PM 7-19-62

RECEIVED
STATE CORPORATION COMMISSION
AUG 13 1962
8-13-62
CONSERVATION DIVISION
Wichita, Kansas

(If additional description is necessary, use BACK of this sheet)
Name of Plugging Contractor Helmerich & Payne, Inc.
Address First National Bldg, Tulsa, Okla

STATE OF Kansas, COUNTY OF Finney, ss.
T. E. Mort (employee of owner) or (owner or operator) of the above-described well, being first duly sworn on oath, says: That I have knowledge of the facts, statements, and matters herein contained and the log of the above-described well as filed and that the same are true and correct. So help me God.

(Signature) T. E. Mort

Box 558, Garden City, Kansas
(Address)

SUBSCRIBED AND SWORN TO before me this 23 day of July 1962

Robert N. Boyd
Notary Public.

My commission expires July 1964



15-101-190290000

Hall No. 2
Helmerich & Payne, Inc.
Section 28-16S-27W
Lane County, Kansas

Casing Record:

13 Joints 8-5/8" Casing @ 284' w/200 sxs.
D&A

Commenced: 7-9-62
Completed: 7-19-62

	<u>FROM</u>	<u>TO</u>
Shale	0	1430
Sand & Shale	1430	2368
Shale & Lime	2368	2688
Shale	2688	3034
Lime & Shale	3034	3165
Shale & Lime	3165	3262
Lime & Shale	3262	3488
Shale & Lime	3488	3735
Lime & Shale	3735	3997
Lime	3997	4045
Lime & Shale	4045	4368
Lime	4368	4475
Lime & Shale	4475	4605
<u>TOTAL DEPTH</u>		<u>4605</u>

RECEIVED
STATE CORPORATION COMMISSION
AUG 13 1962
CONSERVATION DIVISION
Wichita, Kansas

STATE OF OKLAHOMA)
) SS
County of Tulsa)

I hereby affirm that the above and foregoing is a true and correct copy of the log of the Hall No. 2 well, located in Section 28-16S-27W, Lane County, Kansas.

HELMERICH & PAYNE, INC.

Lu Daniel
Vice President

Subscribed and sworn to before me a Notary Public this 2nd day of August, 1962.

My commission expires: March 30, 1964

Margaret Bailey
Notary Public