

STATE OF KANSAS
STATE CORPORATION COMMISSION

15-101-20198-0000

WELL PLUGGING RECORD


Give All Information Completely
Make Required Affidavit
Mail or Deliver Report to
Conservation Division
State Corporation Comm.
245 North Water
Wichita, KS 67202

Lane _____ County. Sec. 29 Twp. 16S Rge. 27W E/W
Location as "NE/CNW $\frac{1}{4}$ SW $\frac{1}{4}$ " or footage from lines _____
C SE SW NW

Lease Owner PETROLEUM, INC.
Lease Name WHEATCROFT 'B' Well No. 1

Office Address 300 West Douglas, Wichita, Kansas 67202

Character of Well (Completed as Oil, Gas or Dry Hole) _____
Dry Hole

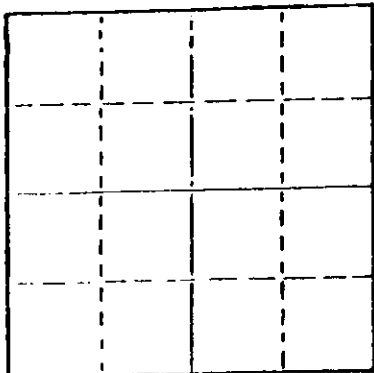

Locate well correctly on above
Section Plot

Date Well completed 12-29 1976
Application for plugging filed 12-29 1976
Application for plugging approved 12-29 1976
Plugging commenced 12-29 1976
Plugging completed 12-29 1976

Reason for abandonment of well or producing formation
No commercial quantities of oil or gas encountered.

If a producing well is abandoned, date of last production
19 _____

Was permission obtained from the Conservation Division or
its agents before plugging was commenced? Yes

Name of Conservation Agent who supervised plugging of this well Leo Massey
Producing formation _____ Depth to top _____ Bottom _____ Total Depth of Well 4670
Show depth and thickness of all water, oil and gas formations.

OIL, GAS OR WATER RECORDS

CASING RECORD

FORMATION	CONTENT	FROM	TO	SIZE	PUT IN	PULLED OUT
Surface Hole	Shale	Surf	287	8-5/8"	279	None

Describe in detail the manner in which the well was plugged, indicating where the mud fluid
was placed and the method or methods used in introducing it into the hold. If cement or other
plugs were used, state the character of same and depth placed, from _____ feet to
_____ feet for each plug set.

Fluid to 900', plug, 70 sx cement;

Fluid to 240', plug, 20 sx cement;

Fluid to 40', plug, 1/2 sx hulls, 10 sx cement.

RECEIVED
STATE CORPORATION COMMISSION

JAN 03 1977

CONSERVATION DIVISION
Wichita, Kansas

(If additional description is necessary, use BACK of this sheet)

Name of Plugging Contractor D N B DRILLING, INC.
701 First National Building
Wichita, Kansas 67202

STATE OF KANSAS COUNTY OF _____, ss.
JAMES L. DONELSON (employee of owner) or (owner or operator)
of the above-described well, being first duly sworn on oath, says: That I have knowledge of
the facts, statements, and matters herein contained and the log of the above-described well
as filed and that the same are true and correct. So help me God.


(Signature) James L. Donelson
701 First Nat'l Bldg., Wichita, Kansas
(Address)

SUBSCRIBED AND SWORN TO before me this 30th day of December, 19 76

Ella Priess
Notary Public.

My commission expires 8-25-80

Ella Priess

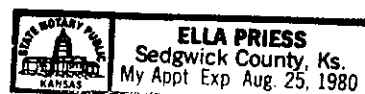

DRILLERS' LOG

1510120198 0000

PETROLEUM, INC.
300 W. Douglas
Wichita, Kansas 67202

Wheatcroft 'B' #1
NE SW 1/4, Sec. 29-16S-27W
Lane County, Kansas

Elev: 2717 (Shot Point)

Commenced: 12-15-76
Completed: 12-28-76

Surface Casing: 279' of 8-5/8"
cemented w/225 sx common cement,
2% gel, 3% cc. 12-15-76

FORMATION

DEPTH

Surface Hole	0 - 287
Shale & Sand	287 - 810
Sand	810 - 840
Shale & Sand	840 - 1584
Blaine Anhydrite	1584 - 1594
Shale & Red Beds	1594 - 1615
Sand	1615 - 2175
Shale	2175 - 2600
Sand & Shale	2600 - 2790
Lime & Shale	2790 - 3080
Shale & Lime	3080 - 3330
Lime & Shale	3330 - 3750
Shale & Lime	3750 - 3925
Lime	3925 - 4670 RTD

RECEIVED
STATE CORPORATION COMMISSION
JAN 03 1977
CONSERVATION DIVISION
Wichita, Kansas

I do hereby certify that the foregoing statements are true and correct to the best of my knowledge and belief.

D N B DRILLING, INC.

James L. Donelson
JAMES L. DONELSON

STATE OF KANSAS: ss:

Subscribed and sworn to before me this 30th day of December, 1976.

Ella Priess
Ella Priess, Notary Public

