


STATE OF KANSAS
STATE CORPORATION COMMISSION

WELL PLUGGING RECORD

Give All Information Completely
Make Required Affidavit
Mail or Deliver Report to
Conservation Division
State Corporation Comm.
245 North Water
Wichita, KS 67202

Rush County. Sec. 24 Twp. 16S Rge. 17 ~~X~~/W
Location as "NE/CNW $\frac{1}{4}$ /SW $\frac{1}{4}$ " or footage from lines
SE SW NE
Lease Owner Black Petroleum Company
Lease Name Urban Well No. 1
Office Address 545 Olive W. Garvey Bldg., Wichita, Ks.
Character of Well (Completed as Oil, Gas or Dry Hole) dry hole

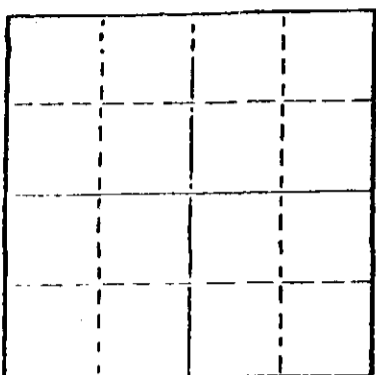

Locate well correctly on above
Section Plat

Date Well completed 2-3 1978
Application for plugging filed 2-3 1978
Application for plugging approved 2-3 1978
Plugging commenced 2-3 1978
Plugging completed 2-3 1978
Reason for abandonment of well or producing formation
no commercial quantities of oil or gas encountered
If a producing well is abandoned, date of last production
-- 19

Was permission obtained from the Conservation Division or
its agents before plugging was commenced? yes
Name of Conservation Agent who supervised plugging of this well Leo Massey
Producing formation Depth to top Bottom Total Depth of Well 3335
Show depth and thickness of all water, oil and gas formations.

OIL, GAS OR WATER RECORDS

CASING RECORD

FORMATION	CONTENT	FROM	TO	SIZE	PUT IN	PULLED OUT
Surface hole	shale	surf	251'	243'	8-5/8"	none

Describe in detail the manner in which the well was plugged, indicating where the mud fluid
was placed and the method or methods used in introducing it into the hold. If cement or other
plugs were used, state the character of same and depth placed, from _____ feet to
_____ feet for each plug set.

Fluid to 420', plug. 50 sx
Fluid to 240', plug. 25 sx
Fluid to 40', plug. 10 sx

02-17-1978

(If additional description is necessary, use BACK of this sheet)

Name of Plugging Contractor D N B Well Co, Inc.
515 R. H. Garvey Bldg.
Wichita, Kansas 67202

STATE OF Kansas COUNTY OF Sedgwick, ss.
Ella Priess (employee of owner) or (owner or operator)
of the above-described well, being first duly sworn on oath, says: That I have knowledge of
the facts, statements, and matters herein contained and the log of the above-described well
as filed and that the same are true and correct. So help me God.

(Signature) Ella Priess
Suite 515, R.H. Garvey Bldg., Wichita, Ks 67202
(Address)

SUBSCRIBED AND SWORN TO before me this 8th day of February, 19 78

My commission expires 4/30/79
Dorothy L. Schmidt
Dorothy L. Schmidt Notary Public.

DOROTHY L. SCHMIDT
STATE NOTARY PUBLIC
Sedgwick Co., Kansas
My Appt. Exp. April 30, 1979

DRILLERS' LOG

BLACK PETROLEUM COMPANY
No. 1 Urban
SE SW NE Sec 24-16S-17W
Rush Co., Kansas

Commenced: 1-28-78
Completed: 2-3-78

Surface Casing: 242.90' of 8-5/8"
cemented w/165 sx common, 2% gel, 3% cc
1-29-78

FORMATION

DEPTH

Surface Hole	0 - 251
Shale & Shells	251 - 518
Sand	518 - 748
Shale	748 - 1119
Anhydrite	1119 - 1156
Shale	1156 - 1460
Shale & Lime	1460 - 1810
Shale	1810 - 2080
Shale & Lime	2080 - 2300
Lime & Shale	2300 - 2490
Shale & Lime	2490 - 2665
Lime & Shale	2665 - 2990
Lime	2990 - 3335 RTD

RECEIVED
STATE CORPORATION COMMISSION
FEB 17 1978
02-17-1978
Wichita, Kansas

I do hereby certify that the foregoing statements are true and correct to the best of my knowledge and belief.

D N B DRILLING, INC.

Ella Priess
Ella Priess

STATE OF KANSAS: ss:

Subscribed and sworn to before me this 8th day of February, 1978.

Dorothy L. Schmidt
Dorothy L. Schmidt, Notary Public

DOROTHY L. SCHMIDT
STATE NOTARY PUBLIC
Sedgwick County, Kansas
My Appt. Exp. April 30, 1979