


STATE OF KANSAS  
STATE CORPORATION COMMISSION

## WELL PLUGGING RECORD

Give All Information Completely  
Make Required Affidavit  
Mail or Deliver Report to  
Conservation Division  
State Corporation Comm.  
245 North Water  
Wichita, KS 67202

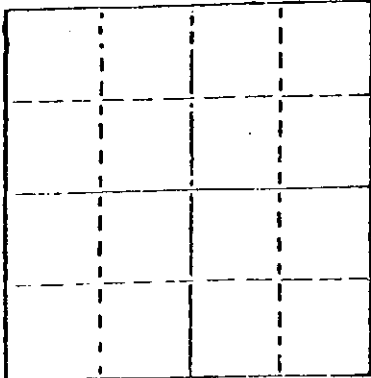

Locate well correctly on above  
Section Map

Rush County. Sec. 24 Twp. 16S Rge. 17 E/W  
Location as "NE/CNW $\frac{1}{2}$ SW $\frac{1}{2}$ " or footage from lines

SW SW NE  
Lease Owner S & J Oil Company

Lease Name Urban Well No. #1

Office Address 1911 Whittier, Hays, Kansas 67601

Character of Well (Completed as Oil, Gas or Dry Hole)

Dry Hole

Date Well completed 9-14-82 19

Application for plugging filed 9-14-82 19

Application for plugging approved 9-14-82 19

Plugging commenced 9-14-82 19

Plugging completed 9-14-82 19

Reason for abandonment of well or producing formation

Commercial quantities of oil not found

If a producing well is abandoned, date of last production 19

Was permission obtained from the Conservation Division or  
its agents before plugging was commenced? Yes

Name of Conservation Agent who supervised plugging of this well Steve Durrant

Producing formation Depth to top Bottom Total Depth of Well 3650'

Show depth and thickness of all water, oil and gas formations.

## OIL, GAS OR WATER RECORDS

## CASING RECORD

FORMATION	CONTENT	FROM	TO	SIZE	PUT IN	PULLED OUT
				8 5/8"	308'	None

Describe in detail the manner in which the well was plugged, indicating where the mud fluid was placed and the method or methods used in introducing it into the hold. If cement or other plugs were used, state the character of same and depth placed, from feet to feet for each plug set.

Plug @ 780' w/70 sx.

Plug @ 330' w/40 sx.

Plug @ 40' w/ 10 sx.

Rat Hole 10 sx.

(If additional description is necessary, use BACK of this sheet)

Name of Plugging Contractor Rains & Williamson Oil Co., Inc.

STATE OF Kansas COUNTY OF Sedgwick, ss.

Wilson Rains, President of Rains & Williamson Oil Co., (Employee of owner) or (owner or operator) of the above-described well, being first duly sworn on oath, says: That I have knowledge of the facts, statements, and matters herein contained and the log of the above-described well as filed and that the same are true and correct. So help me God.

(Signature) Wilson Rains

435 Page Court, 220 W. Douglas, Wichita, Ks. 67202

(Address)

SUBSCRIBED AND SWORN TO before me this 20 day of September, 1982

My commission expires

10-4-83

Juanita M. Green

Notary Public.

OCT 29 1982

10-29-1982

CONSERVATION DIVISION  
Wichita, Kansas