


15101-20757-0000

WELL PLUGGING RECORD

Give All Information Completely
 Make Required Affidavit

COUNTY Lane SEC. 34 TWP. 16S RGE 27 W
 Location as in quarters or footage from lines:
N/2 NE NE

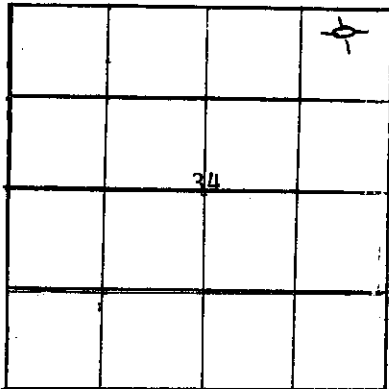

Locate Well
 correctly on above
 Section Platt.

Lease Owner Landmark Oil Exploration, Inc.
 Lease Name Foster Well No. 1
 Office Address 105 South Broadway - Suite 1040, Wichita, KS 67202
 Character of Well (Completed as Oil, Gas or Dry Hole): D&A
 Date Well Completed February 18, 1983
 Application for plugging filed February 17, 1983
 Plugging commenced February 18, 1983
 Plugging completed February 18, 1983
 Reason for abandonment of well or producing formation D&A

Was permission obtained from the Conservation Division or it's
 Agent's before plugging was commenced? yes

Name of Conservation Agent who supervised plugging of this well Steve Durant

Producing formation _____ Depth to top _____ bottom _____ T.D. 4580'

Show depth and thickness of all water, oil and gas formations.

OIL, GAS OR WATER RECORDS Casing Record

Formation	Content	From	To	Size	Put in	Pulled Out
				8-5/8"	316'	-0-

Describe in detail the manner in which the well was plugged, indicating where the mud
 fluid was placed and the method or methods used in introducing it into the hold. If cement
 or other plugs were used, state the character of same and depth placed, from _____ feet
 to _____ feet for each plug set.

2058' w/50 sx
 960' w/25 sx
 360' w/40 sx
 40' w/ 10 sx
 10 sx in rathole
 Cmt. w/135 sx 50-50 poz, 4% gel., 3% c.c.

RECEIVED
 STATE CORPORATION COMMISSION
 STATE CORPORATION COMMISSION
 3-18-83
 MAR 10 1983
 CONSERVATION DIVISION
 CONSERVATION DIVISION
 Wichita, Kansas

(If additional description is necessary, use BACK of this sheet)

Name of Plugging Contractor Halliburton
6th Floor, Colo. Derby Bldg., Wichita, KS 67202

STATE OF Kansas COUNTY OF Sedgwick, ss.
Jeffrey R. Wood (~~employee of owner~~) or (~~owner~~) or operator) of the
 above-described well, being first duly sworn on oath, says: That I have knowledge of the
 facts, statements, and matters herein contained and the log of the above-described well as
 filed and that the same are true and correct. So help me God.

(Signature) [Signature]
105 S. Broadway, Ste. 1040
Wichita, (Address) KS 67202

SUBSCRIBED AND SWORN TO before me this 9th day of March, 19 83

Georgia A. Bonat
 Georgia A. Bonat Notary Public.

My Commission expires: 1/4/86

