


STATE OF KANSAS  
STATE CORPORATION COMMISSION

WELL PLUGGING RECORD

Give All Information Completely  
Make Required Affidavit  
Mail or Deliver Report to:  
Conservation Division  
State Corporation Commission  
211 No. Broadway  
Wichita, Kansas

NORTH

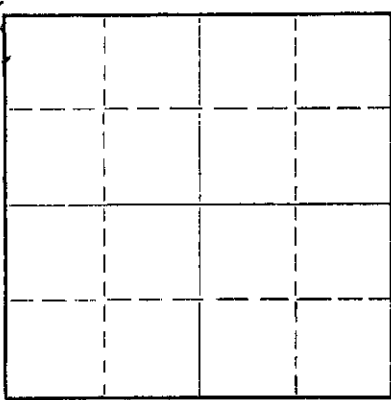

Locate well correctly on above  
Section Plat

Rush County. Sec. 16 Twp. 16S Rge. 17W (E) (W)  
Location as "NE/CNW/SW" or footage from lines SE SE SW  
Lease Owner Frontier Oil Company  
Lease Name Urban "A" Well No. 1  
Office Address 1720 Wichita Plaza, Wichita, Kansas  
Character of Well (completed as Oil, Gas or Dry Hole) D & A  
Date well completed January 5, 1964  
Application for plugging filed January 5, 1964  
Application for plugging approved January 5, 1964  
Plugging commenced January 5, 1964  
Plugging completed January 5, 1964  
Reason for abandonment of well or producing formation D & A

If a producing well is abandoned, date of last production 19  
Was permission obtained from the Conservation Division or its agents before plugging was commenced? Yes

Name of Conservation Agent who supervised plugging of this well Eldon Petty  
Producing formation \_\_\_\_\_ Depth to top \_\_\_\_\_ Bottom \_\_\_\_\_ Total Depth of Well 3571 Feet  
Show depth and thickness of all water, oil and gas formations.

OIL, GAS OR WATER RECORDS CASING RECORD

FORMATION	CONTENT	FROM	TO	SIZE	PUT IN	PULLED OUT
				8 5/8"	1140'	-0-

Describe in detail the manner in which the well was plugged, indicating where the mud fluid was placed and the method or methods used in introducing it into the hole. If cement or other plugs were used, state the character of same and depth placed, from \_\_\_\_\_ feet to \_\_\_\_\_ feet for each plug set.

Hole filled @ 480' with heavy mud, plug - 1/2 sx hulls & 20 sx cement.  
Filled with heavy mud to 180', plug - 1/2 sx hulls & 20 sx cement. Filled to 30' with heavy mud, plug - 1/2 sx hulls & 10 sx cement.

RECEIVED  
STATE CORPORATION COMMISSION

JAN 9 1964  
01-09-1964  
CONSERVATION DIVISION  
Wichita, Kansas

(If additional description is necessary, use BACK of this sheet)

Name of Plugging Contractor Red Tiger Drilling Company  
Address Box 173 -- Russell, Kansas

STATE OF KANSAS, COUNTY OF SEDGWICK, ss.  
George A. Angle (owner or operator) of the above-described well, being first duly sworn on oath, says: That I have knowledge of the facts, statements, and matters herein contained and the log of the above-described well as filed and that the same are true and correct. So help me God.

(Signature) George A. Angle  
1720 Wichita Plaza, Wichita, Kansas  
(Address)

SUBSCRIBED AND SWORN TO before me this 8th day of January, 1964

Jean Hollan  
Notary Public.

My commission expires 5-22-66

15-165-01638-00-00

DRILLERS LOG

No. 1 Urban "A"

CASING RECORD:

8 5/8" @ 1140'  
w/475 sx cement

COMPANY: Frontier Oil Company

CONTRACTOR: Red Tiger Drilling Co.

COMMENCED: December 26, 1963

COMPLETED: January 5, 1964

DESCRIPTION:

SE SE SW  
16-16S-17W  
Rush County,  
Kansas

ELEVATION: 1998 DF  
2001 RB

TOTAL DEPTH: 3571'

<u>FORMATION</u>	<u>FROM</u>	<u>TO</u>	<u>REMARKS</u>
Sod & Post Rock	0	40	
Post Rock	40	75	
Shale & Shells	75	500	
Sand	500	675	
Sand & Shale	675	785	
Shale	785	885	
Red Bed & Shale	885	1127	
Anhydrite	1127	1160	
Red Bed & Shale	1160	1585	
Shale & Shells	1585	1825	
Lime & Shale	1825	1920	
Shale	1920	2155	
Lime & Shale	2155	2960	
Lime	2960	3571	

RECEIVED  
STATE CORPORATION COMMISSION

JAN 9 1964  
01-09-1964  
CONSERVATION DIVISION  
Wichita, Kansas

I certify that this is a true and correct copy of the above log to the best of my knowledge.

FRONTIER OIL COMPANY

George A. Angle  
George A. Angle

Subscribed and sworn to before me this 8th day of January, 1964.

Jean Hollan  
Notary Public

My Commission Expires:

5-22-66