


WELL PLUGGING RECORD

Give All Information Completely
Make Required Affidavit
Mail or Deliver Report to:
Conservation Division
State Corporation Commission
211 No. Broadway
Wichita, Kansas

Rush County, Sec. 16 Twp. 16S Rge. 17W (E) (W)

Location as "NE/CNW/SW" or footage from lines C NW NW
Lease Owner Frontier Oil Company
Lease Name Thielenhaus Well No. 1
Office Address 1720 Wichita Plaza, Wichita, Kansas
Character of Well (completed as Oil, Gas or Dry Hole) Dry Hole
Date well completed October 16, 19 65
Application for plugging filed October 16, 19 65
Application for plugging approved October 16, 19 65
Plugging commenced October 16, 19 65
Plugging completed October 16, 19 65
Reason for abandonment of well or producing formation D & A

NORTH

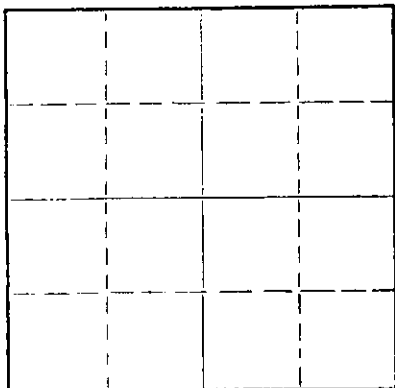

Locate well correctly on above
Section Plat

If a producing well is abandoned, date of last production 19
Was permission obtained from the Conservation Division or its agents before plugging was commenced? Yes

Name of Conservation Agent who supervised plugging of this well Eldon Petty
Producing formation _____ Depth to top _____ Bottom _____ Total Depth of Well 3542 Feet
Show depth and thickness of all water, oil and gas formations.

OIL, GAS OR WATER RECORDS

CASING RECORD

FORMATION	CONTENT	FROM	TO	SIZE	PUT IN	PULLED OUT
				8 5/8"	1079'	-0-

Describe in detail the manner in which the well was plugged, indicating where the mud fluid was placed and the method or methods used in introducing it into the hole. If cement or other plugs were used, state the character of same and depth placed, from _____ feet to _____ feet for each plug set.

Filled hole with mud to 420',
hulls, plug, 20 sx thru D.P.,
mud to 180', hulls, plug, 20 sx
thru D.P., mud to 35', hulls,
plug. Cement to base of cellar,
2 sx in rathole.

RECEIVED
STATE CORPORATION COMMISSION

OCT 28 1965
10-28-1965
CONSERVATION DIVISION
Wichita, Kansas

(If additional description is necessary, use BACK of this sheet)
Name of Plugging Contractor Red Tiger Drilling Company
Address Box 173 -- Russell, Kansas

STATE OF KANSAS, COUNTY OF SEDGWICK, ss.
Maxine V. Starr (employee of owner) or ~~owner or operator~~ of the above-described well, being first duly sworn on oath, says: That I have knowledge of the facts, statements, and matters herein contained and the log of the above-described well as filed and that the same are true and correct. So help me God.

(Signature) Maxine V. Starr
1720 Wichita Plaza, Wichita, Kansas
(Address)

SUBSCRIBED AND SWORN TO before me this 26th day of October, 19 65

Jean Hollan
Notary Public.

15-165-30087-00-00

DRILLERS LOG

Thielenhaus No. 1

CASING RECORD: 8 5/8" @ 1079' w/475 sx cement

COMPANY: Frontier Oil Company

CONTRACTOR: Red Tiger Drilling Company

COMMENCED: October 7, 1965

COMPLETED: October 16, 1965

DESCRIPTION: C NW NW
16-16S-17W
Rush Co., Ks.

ELEVATION: 1938 DF
1941 RB

TOTAL DEPTH: 3542'

<u>FORMATION</u>	<u>FROM</u>	<u>TO</u>	<u>REMARKS</u>
Surface Soil & Rock & Clay	0	95	
Shale & Shells	95	210	
Shale	210	478	
Dakota Sand	478	718	
Redbed	718	1068	
Anhydrite	1068	1107	
Shale & Shells	1107	1260	
Shale & Shells & Salt	1260	1789	
Lime & Shale	1789	2950	
Lime	2950	3180	
Lime & Shale	3180	3199	
Heebner	3199	3203	
Lime & Shale	3203	3250	
Lime	3250	3480	
Brown Lime & Sand	3480	3542	

RECEIVED
STATE CORPORATION COMMISSION
OCT 28 1965
10-28-1965
CONSERVATION DIVISION
TOPEKA, KANSAS

I certify that this is a true and correct copy of the above log to the best of my knowledge.

FRONTIER OIL COMPANY

Maxine V. Starr
Maxine V. Starr

Subscribed and sworn to before me this 25th day of October, 1965.

Dean Kollar
Notary Public

My Commission Expires:

5-22-66