


STATE OF KANSAS
STATE CORPORATION COMMISSION
Give All Information Completely
Make Required Affidavit
Mail or Deliver Report to:
Conservation Division
State Corporation Commission
800 Biting Building
Wichita, Kansas

OR
FORMATION PLUGGING RECORD

Strike out upper line
when reporting plug-
ging off formations.

Rush County, Sec. 16 Twp. 16 Rge. 17 (E) W (W)

Location as "NE 1/4 NW 1/4 SW 1/4" or footage from lines NE NE SW 1/4
Lease Owner Urban Royer-Farris Eldorado Refr. Co
Lease Name Urban Well No. 1
Office Address 709 Brown Bldg. Wichita 2 Kansas
Character of Well (completed as Oil, Gas or Dry Hole) Dry Hole
Date, well completed Jan. 30 1944 19
Application for plugging filed Jan. 31 1944 19
Application for plugging approved Jan. 31 1944 19
Plugging Commenced Feb. 1 1944 19
Plugging Completed Feb. 1 1944 19
Reason for abandonment of well or producing formation Dry Hole

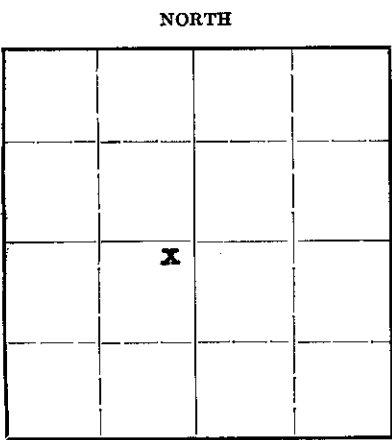

Locate well correctly on above
Section Plat

If a producing well is abandoned, date of last production Dry Hole 19
Was permission obtained from the Conservation Division or its agents before plugging was com-
menced? Yes

Name of Conservation Agent who supervised plugging of this well C.T. Alexander
Producing formation Depth to top 3553 Bottom 3585 Total Depth of Well 3585 Feet
Show depth and thickness of all water, oil and gas formations.

OIL, GAS OR WATER RECORDS

CASING RECORD

Formation	Content	From	To	Size	Put In	Pulled Out
Arbuckle	water	3553	3585	no pipe set 10"	306'	None

Describe in detail the manner in which the well was plugged, indicating where the mud fluid was placed and the method or methods used in introducing it into the hole. If cement or other plugs were used, state the character of same and depth placed, from 304 feet to 6 feet for each plug set.

Hole was pumped full of thick mud from bottom to 304', spotted 15 sack cement plug from 304 to 255' pumped in thick mud and spotted 10 sack cement plug from 26' to 6', cut off top of surface pipe below plow depth and welded same shut with metal plate.

PLUGGING
FILE 16-16-120
BOOK PAGE 107 LINE 8

FEB 02-03-1944

(If additional description is necessary, use BACK of this sheet)

Correspondence regarding this well should be addressed to Royer-Farris Drilling Company
Address 709 Brown Bldg. Wichita, 2 Kansas.


STATE OF Kansas, COUNTY OF Sedgwick, ss.
L.A. Farris (employee of owner) or (owner or operator) of the above-described well,
being first duly sworn on oath, says: That I have knowledge of the facts, statements, and matters herein contained and the log of the above-described well as filed and that the same are true and correct. So help me God.

(Signature) [Handwritten Signature]

SUBSCRIBED AND SWORN to before me this 3 day of February 1944

Effie L. Lote
Notary Public.

My commission expires April 23, 1945

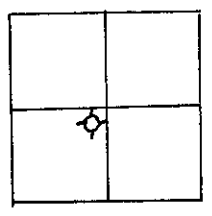

Drilling Started: January 9, 1944.
Completed: January 31, 1944.
Elevation: 1792'.
306' of 10" Surface Pipe

Figures Indicate Bottom of Formations

soil	0	10	lime	3098	3205
yellow clay	10	30	lime & shale	3205	3251
gravel	30	40	shale	3251	3255
shale-shells	40	270	lime	3255	3552
shale	270	295	conglomerate	3552	3555
lime	295	304	Arbuckle	3555	3563
shale-shells	304	495	Dolomite	3563	3585
sand	495	745			
red rock	745	1040	T.D.	3585'	D&A
red rock-shells	1040	1125			
anhydrite	1125	1165			
shale-shells	1165	1480			
shale-shells-salt	1480	1825			
anhydrite	1825	1840			
lime	1840	1890			
lime-chert	1890	1980			
lime-shells-shale	1980	2075			
lime	2075	2220			
lime-shale	2220	2265			
lime	2265	2525			
B. lime & shale	2525	2600			
lime	2600	2655			
lime & shale	2655	2705			
lime-shells & shale	2705	2765			
lime	2765	2800			
lime & shale	2800	2885			
shale	2885	2947			
lime	2947	3023			
lime & shale	3023	3098			

PLUGGING
FILE 16 16-276
BOOK PAGE 227 NE 6-

L. A. Farris does hereby swear that he is a partner of the firm, Royer-Farris Drilling Company, who were the drilling contractors on the above described well and that the above log is true and correct to the best of his knowledge and belief.

STATE OF KANSAS)
) SS
COUNTY OF SEDGWICK)

BE IT REMEMBERED, That on this 8th day of February, A.D. 1944, before me, a Notary Public in and for said County and State, personally appeared L. A. Farris to me known to be the identical person described in and who executed the within and foregoing instrument and acknowledged to me that he executed the same as his free and voluntary act and deed for the uses and purposes therein set forth.

IN WITNESS WHEREOF, I have hereunto set my official signature and affixed my notarial seal, the day and year first above written.

My commission expires January 10, 1948.

Constance Lindahl
Notary Public

MAR 20 1944
03-25-1944