


Give All Information Completely
Make Required Affidavit
Mail or Deliver Report to:
Conservation Division
State Corporation Commission
211 No. Broadway
Wichita, Kansas

CP4

15-121-01371-0000
WELL PLUGGING RECORD

NORTH

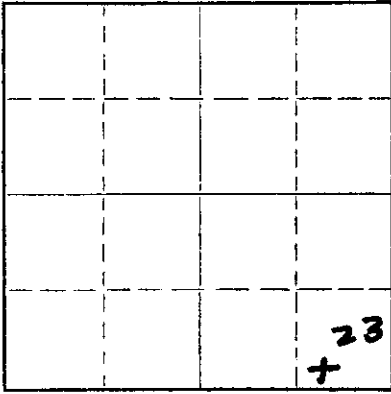

Locate well correctly on above Section Plat

Miami County. Sec. 29 Twp. 17 Rge. 23 (E) E (W)
Location as "NE/CNW&SW" or footage from lines SE 1/4, 200' N and 800' west of
Lease Owner Sydney Spofforth SE corner.
Lease Name C.W. Davis Well No. 23
Office Address Box 371, Paola, Kansas
Character of Well (completed as Oil, Gas or Dry Hole) Dry hole
Date well completed July 1956 19
Application for plugging filed March 1957 19
Application for plugging approved 3. 6. 1957 19
Plugging commenced March 1957 19
Plugging completed March 1957 19
Reason for abandonment of well or producing formation Dr hole

If a producing well is abandoned, date of last production none 19
Was permission obtained from the Conservation Division or its agents before plugging was commenced? Yes

Name of Conservation Agent who supervised plugging of this well A.L. Sides
Producing formation none Depth to top Bottom Total Depth of Well 368 Feet
Show depth and thickness of all water, oil and gas formations.

OIL, GAS OR WATER RECORDS

CASING RECORD

FORMATION	CONTENT	FROM	TO	SIZE	PUT IN	PULLED OUT
No formations productive at usual levels.		No water in hole.				

Describe in detail the manner in which the well was plugged, indicating where the mud fluid was placed and the method or methods used in introducing it into the hole. If cement or other plugs were used, state the character of same and depth placed, from _____ feet to _____ feet for each plug set.

Cemented at bottom 5 sacks cement. Filled with wooden plugs, shale, gravel cemented. Bridged 40 ft. from top, plugged and cemented at bridge. Cemented at top of hole with 3 sacks cement.

(If additional description is necessary, use BACK of this sheet)

Name of Plugging Contractor Frank Crooks
Address Le Roy, Kansas

STATE OF Kansas COUNTY OF Miami, ss.
Sydney Spofforth (employee of owner) or (owner or operator) of the above-described well, being first duly sworn on oath, says: That I have knowledge of the facts, statements, and matters herein contained and the log of the above-described well as filed and that the same are true and correct. So help me God.

(Signature) Sydney Spofforth
(Address)

SUBSCRIBED AND SWORN TO before me this 11th day of April, 19 57

My commission expires _____
Gallen Barnett Notary Public

PLUGGING
FILE SEC 29 T 17 R 23E
BOOK PAGE 6 LINE 33